


STATE OF KANSAS
STATE CORPORATION COMMISSION

Give All Information Completely
Make Required Affidavit
Mail or Deliver Report to:
Conservation Division
State Corporation Commission
211 No. Broadway
Wichita, Kansas

WELL PLUGGING RECORD

NORTH

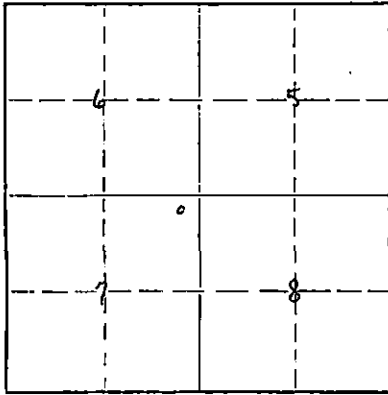

Locate well correctly on above
Section Plat

Pawnee County, Sec. 7 Twp. 22S Rge. 19 (E) (W)
Location as "NE/CNW/SW" or footage from lines. NE NE NE
Lease Owner Tomlinson Oil Co., Inc.
Lease Name Polson Well No. 1
Office Address Suite 1030, 200 W. Douglas, Wichita, Kansas 67202
Character of Well (completed as Oil, Gas or Dry Hole) Dry Hole
Date well completed June 2, 19 73
Application for plugging filed June 1, 19 73
Application for plugging approved June 4, 1973. 19 73
Plugging commenced June 2, 19 73
Plugging completed June 2, 19 73
Reason for abandonment of well or producing formation Dry Hole

If a producing well is abandoned, date of last production 19
Was permission obtained from the Conservation Division or its agents before plugging was commenced? Yes

Name of Conservation Agent who supervised plugging of this well Leo F. Massey
Producing formation Depth to top Bottom Total Depth of Well 3829 Feet
Show depth and thickness of all water, oil and gas formations.

OIL, GAS OR WATER RECORDS

CASING RECORD

FORMATION	CONTENT	FROM	TO	SIZE	PUT IN	PULLED OUT

Describe in detail the manner in which the well was plugged, indicating where the mud fluid was placed and the method or methods used in introducing it into the hole. If cement or other plugs were used, state the character of same and depth placed, from feet to feet for each plug set.

Plug and 25 sacks at 300'
Plug and 15 sacks at 40'
Washdown of previously drilled well.

RECEIVED
STATE CORPORATION COMMISSION

OCT 30 1973

CONSERVATION DIVISION
Wichita, Kansas

10-30-1973

(If additional description is necessary, use BACK of this sheet)

Name of Plugging Contractor Hellar Drilling Company
Address 339 Union Center Building, Wichita, Kansas 67202

STATE OF Kansas, COUNTY OF Sedgwick, ss.

E. B. Krider, Tomlinson Oil Co., Inc. (employee of owner) or (owner or operator) of the above-described well, being first duly sworn on oath, says: That I have knowledge of the facts, statements, and matters herein contained and the log of the above-described well as filed and that the same are true and correct. So help me God.

(Signature)

Robert J. Gill

Suite 1030, 200 West Douglas, Wichita, Kansas 67202

(Address)

SUBSCRIBED AND SWORN TO before me this 26th day of October, 19 73

My commission expires

22 February 1976

Notary Public.

NE/4 NE/4 NE/4 of Section 7-22S-19W Pawnee County, Kansas

Rigged up Rotary Tools 4/29/55

Tore Down Rotary Tools 5/18/55

Ran 32 Jts (975.15') 8 5/8 - 32# 8 Rd Tnd
 Class "B" Pipe set @ 973'. Cemented with
 250 sacks cement, 1% Cal. Cl; 250 sacks
 cement, 2% Gel, 1% Cal. Cl.

FORMATION	FROM	TO
Clay & sand	0'	40'
Shale w/lime shells	40	380
Sand (hard)	380	470
Sand & shale	470	575
Shale & shells	575	685
Sand	685	735
Shale, shells & redbed	735	974
Shale & redbed	974	1225
Anhydrite	1225	1265
Shale & shells	1265	1474
Shale & salt	1474	1550
Shale	1550	1775
Lime & shale	1775	1875
Lime, sand & shale	1875	2080
Lime & sand	2080	2110
Shale w/lime streaks	2110	2209
Lime w/shale streaks	2209	2377
Lime & sand w/shale streaks	2377	2450
Lime & sand w/shale streaks	2450	2545
Lime, sand & chert	2545	2605
Lime & sand	2605	2796
Lime & shale	2796	2924
Lime w/shale streaks	2924	3173
Lime & shale	3173	3499
Lime	3499	3763
Lime w/some chert	3763	3787
Lime & chert	3787	3815
Lime	3815	4098
Lime & shale	4098	4297
Conglomerate	4297	4337
Lime & chert	4337	4384
Chert	4384	4410
Lime & chert	4410	4443
Lime, shale, dolomite & sand	4443	4495
Lime, dolomite, sand & chert	4495	4515
Lime & chert	4515	4558
Lime, dolomite & shale	4558	4582
Lime, shale & chert	4582	4625
Lime	4625	4670 TD

RECEIVED
 STATE CORPORATION COMMISSION

OCT 16 1973

CONSERVATION DIVISION
 Wichita, Kansas

I, Don S. Packer, do hereby certify that the foregoing log is true and correct,
 to the best of my knowledge and belief.

Don S. Packer
 Don S. Packer

Subscribed and sworn to before me this 18th day of May, 1955

Leota Lee Miller
 Leota Lee Miller

My commission expires: July 27, 1955

PLUGGING
 REC 32C 7-22-19W
 EXOK PAGE 120 LINE 42

STATE CORPORATION COMMISSION
 MAY 25 1955
 CONSERVATION DIVISION
 Wichita, Kansas