

STATE OF KANSAS
STATE CORPORATION COMMISSION

Give All Information Completely
Make Required Affidavit
Mail or Deliver Report to:
Conservation Division
State Corporation Commission
211 No. Broadway
Wichita, Kansas

WELL PLUGGING RECORD

Pawnee County, Sec. 9 Twp. 22S Rge. (E)-19 (W)

Location as "NE/CNW/SW" or footage from lines Ctr. NE NW

Lease Owner Graybol Oil Corporation

Lease Name Schartz Well No. 1

Office Address 2200 National Bank of Tulsa Bldg., Tulsa, Oklahoma 74103

Character of Well (completed as Oil, Gas or Dry Hole) Dry Hole

Date well completed December 30 19 64

Application for plugging filed December 30 19 64

Application for plugging approved December 30 19 64


Plugging commenced December 30 19 64

Plugging completed December 30 19 64

Reason for abandonment of well or producing formation _____

If a producing well is abandoned, date of last production _____ 19 _____

Was permission obtained from the Conservation Division or its agents before plugging was commenced? Yes

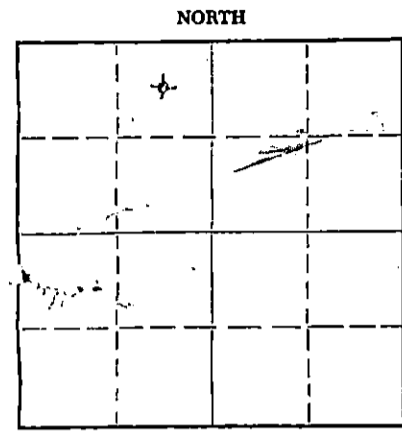

Locate well correctly on above Section Plat

Name of Conservation Agent who supervised plugging of this well Eldon Petty

Producing formation None Depth to top _____ Bottom _____ Total Depth of Well 4369 Feet

Show depth and thickness of all water, oil and gas formations.

OIL, GAS OR WATER RECORDS

CASING RECORD

FORMATION	CONTENT	FROM	TO	SIZE	PUT IN	PULLED OUT
Lansing limestone	Water	3743	4061	8 5/8"	242'	None
Conglomerate	Water	4270	4276			
Mississippian	Water	4306	4369			

Describe in detail the manner in which the well was plugged, indicating where the mud fluid was placed and the method or methods used in introducing it into the hole. If cement or other plugs were used, state the character of same and depth placed, from _____ feet to _____ feet for each plug set.

Filled hole with heavy mud-laden fluid. Put swedge in top of 8 5/8" surface casing and squeezed with 125 sacks of cement. Cemented by Service Company (Halliburton).

RECEIVED
STATE CORPORATION COMMISSION

JAN 5 1965

CONSERVATION DIVISION
Wichita, Kansas

1-5-1965

(If additional description is necessary, use BACK of this sheet)

Name of Plugging Contractor None used.

Address _____

STATE OF OKLAHOMA, COUNTY OF TULSA, ss.
Lyman C. Dennis (employee of owner) or (~~AGENT OF OWNER~~) of the above-described well, being first duly sworn on oath, says: That I have knowledge of the facts, statements, and matters herein contained and the log of the above-described well as filed and that the same are true and correct. So help me God.

(Signature) Lyman C. Dennis

Tulsa, Oklahoma

(Address)

SUBSCRIBED AND SWORN to before me this 4th day of January 19 65

My commission expires October 2, 1967

Nancy Ann Elder
Notary Public.

GRAYBOL OIL CORPORATION

Pawnee County, Kansas

No. 1 Schartz

Ctr. NE NW Sec. 9-22S-19W

Contractor: Company Tools

Elev. 2099 D.F., 2093 G.L.

Commenced: December 15, 1964

Completed: December 30, 1964

Production: Dry and Abandoned

RECEIVED
STATE CORPORATION COMMISSION

JAN 5 1965

CASING RECORD

CONSERVATION DIVISION
Wichita, Kansas

Set 8 5/8" surface casing at 242' with 150 sacks of Portland cement.

<u>DEPTH</u>	<u>FORMATION</u>	<u>WELEX ELECTROLOG TOPS:</u>	
0-240	Sand and shale	Stone Corral anhydrite	1204 (+895)
240-640	Shale and red bed	Heebner shale	3665 (-1566)
640-915	Sand	Lansing limestone	3743 (-1644)
915-1225	Shale, sand and shells	Base of Kansas City	4061 (-1962)
1225-1236	Anhydrite	Cherokee shale	4222 (-2123)
1236-1540	Shale	Conglomerate	4270 (-2171)
1540-1995	Shale and shells	Mississippian	4306 (-2207)
1995-2140	Lime with shale	Welex Total Depth	4373
2140-2350	Lime		
2350-2475	Lime with shale	Drill Stem Test #1 - 4305-4320. Tool	
2475-2990	Lime and shale	open one hour. Recovered 160' muddy	
2990-3120	Shale and lime	water with a few specks of oil. IBHP-	
3120-3215	Lime and shale	1357#/30", FBHP-1237#/30", IFP-18#,	
3215-3315	Lime with shale	FFP-91#..	
3315-3438	Shale and lime		
3438-3530	Lime and shale		
3530-3630	Lime		
3630-3740	Lime and shale		
3740-3860	Lime		
3860-3871	Cherty lime		
3871-4200	Lime		
4200-4225	Lime and shale		
4225-4275	Lime		
4275-4320	Cherty lime and shale		
4320-4369	Chert		
4369	Driller's Total Depth		

I hereby certify that the above is a true and correct log of the above-captioned well as taken directly from the daily drilling reports.

GRAYBOL OIL CORPORATION

BY: Lyman C. Dennis
Lyman C. Dennis, Geologist

STATE OF OKLAHOMA

COUNTY OF TULSA

Subscribed and sworn to this 4th day of January, 1965.

My Commission expires: October 2, 1967

James J. Elder
NOTARY PUBLIC