

STATE OF KANSAS
STATE CORPORATION COMMISSION

Form CP-4


Give All Information Completely
Make Required Affidavit
Mail or Deliver Report to:
Conservation Division
State Corporation Commission
212 No. Market
Wichita, Kansas 67202

WELL PLUGGING RECORD

Pawnee County, Sec. 23 Twp. 22S Rge. 19W (E) (W)

Location as "NE/CNWESW" or footage from lines SW¹/₄ SW¹/₄
Lease Owner Antares Oil Corporation
Lease Name Gail Colglazier Well No. 1
Office Address 1660 Lincoln St., #1530, Denver, CO 80264
Character of Well (completed as Oil, Gas or Dry Hole) Dry Hole
Date well completed May 28 19 79
Application for plugging filed verbal to Wilmer Dreiling 19
Application for plugging approved from Marion Schmidt 19
Plugging commenced 3:45 PM May 28 19 79
Plugging completed 11:00 PM May 28 19 79
Reason for abandonment of well or producing formation Dry Hole

NORTH

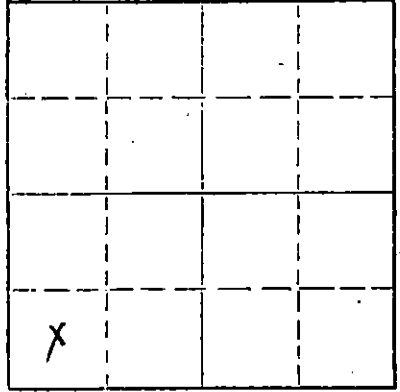

Locate well correctly on above Section Plat

If a producing well is abandoned, date of last production 19
Was permission obtained from the Conservation Division or its agents before plugging was commenced? yes

Name of Conservation Agent who supervised plugging of this well Marion Schmidt
Producing formation Depth to top Bottom Total Depth of Well 4430 Feet
Show depth and thickness of all water, oil and gas formations.

OIL, GAS OR WATER RECORDS CASING RECORD

FORMATION	CONTENT	FROM	TO	SIZE	PUT IN	PULLED OUT
				8 5/8"	2258'	None

Describe in detail the manner in which the well was plugged, indicating where the mud fluid was placed and the method or methods used in introducing it into the hole. If cement or other plugs were used, state the character of same and depth placed, from feet to feet for each plug set.

Plug #1 set at 660' with 60 sacks cement.
Plug #2 set at 250' with 20 sacks cement.
Plug #3 set at 40' with solid bridge and 10 sacks cement.
Hole was conditioned with heavy drilling mud.

7-9-79
RECEIVED
STATE CORPORATION COMMISSION
JUL - 9 1979
CONSERVATION DIVISION
Wichita, Kansas

(If additional description is necessary, use BACK of this sheet)
Name of Plugging Contractor Halliburton (HOWCO)
Address 410 Union Center, Wichita, Kansas 67202

STATE OF COLORADO, COUNTY OF DENVER, ss.
HAL C. PORTER (Notary Public) or (owner or operator) of the above-described well, being first duly sworn on oath, says: That I have knowledge of the facts, statements and matters herein contained and the log of the above-described well as filed and that the same are true and correct. So help me God.

(Signature) [Signature]
1660 Lincoln St., #1530, Denver, CO 80264 (Address)

SUBSCRIBED AND SWORN to before me this 3rd day of July, 1979.
My Commission Expires May 14, 1983
Barbara A. Pensiero Notary Public.

GABBERT-JONES, INC.
 WICHITA, KANSAS
 DRILLERS' WELL LOG

Colglazier #1
 C SW SW Sec 23-228-19W
 Pawnee County Kansas

Commenced: 5-18-79

Completed: 5-28-79

OPERATOR: ANTARES OIL CO.

Depth		Formation	Remarks	
From	to			
0	258	Shale-Sand	Ran 30 jts of 23 & 28# 8 5/8" csg set @ 1228' w/Notched Texas Pattern Shoe - 3 Centerlizers Cemented w/550 sks 50/50 Posmix 2 % Gel 3% CC PD @ 6:45 p.m. 5-19-79	
258	480	Shale		
480	648	Redbed		
648	750	Sand		
750	1219	Shale		
1219	1250	Anhy		
1250	1840	Shale-Shells		
1840	3988	Lime-Shale		
3988	4200	Lime		
4200	4308	Lime-Shale		
4308	4430	Lime		
	4430 - TD			DRY & ABANDONED

STATE OF KANSAS)
) SS.
 COUNTY OF SEDGWICK)

I, the undersigned, being duly sworn on oath, state that the above
 Drillers' Well Log is true and correct to the best of my knowledge and belief and
 according to the records of this office.

GABBERT-JONES, INC.

James S. Sutton II
 JAMES S. SUTTON II

Subscribed and sworn to before me this 14th day of June, 1979.

Elizabeth J. Edwards
 ELIZABETH J. EDWARDS-NOTARY PUBLIC

My Commission expires February 6, 1983.

RECEIVED
 STATE CORPORATION COMMISSION

JUL - 9 1979

CONSERVATION DIVISION
 Wichita, Kansas

