


STATE OF KANSAS
STATE CORPORATION COMMISSION

WELL PLUGGING RECORD

Give All Information Completely
Make Required Affidavit
Mail or Deliver Report to
Conservation Division
State Corporation Comm.
245 North Water
Wichita, KS 67202

Pawnee County, Sec. 27 Twp. 22 Rge. 19 R/W
Location as "NE/CNW $\frac{1}{4}$ SW $\frac{1}{4}$ " or footage from lines
660' FWL, 1980' FSL, SW $\frac{1}{4}$
Lease Owner Maguire Oil Company
Lease Name Spomer Well No. 1
Office Address 4200 First Nat. Bank, Dallas Tx. 75202
Character of Well (Completed as Oil, Gas or Dry Hole)
Dry and Abandoned

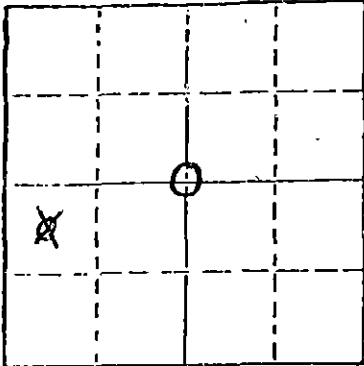

Locate well correctly on above
Section Plat

Date Well completed 8-22 19 80
Application for plugging filed 8-22 19 80
Application for plugging approved 8-22 19 80
Plugging commenced 7:00 P.M. 8-22 19 80
Plugging completed 12:00 P.M. 8-22 19 80
Reason for abandonment of well or producing formation
Dry Hole

If a producing well is abandoned, date of last production
19

Was permission obtained from the Conservation Division or
its agents before plugging was commenced? Yes

Name of Conservation Agent who supervised plugging of this well Marion Schmidt
Producing formation Depth to top Bottom Total Depth of Well 4850
Show depth and thickness of all water, oil and gas formations.

OIL, GAS OR WATER RECORDS				CASING RECORD		
FORMATION	CONTENT	FROM	TO	SIZE	PUT IN	PULLED OUT
				8 5/8	919	

Describe in detail the manner in which the well was plugged, indicating where the mud fluid
was placed and the method or methods used in introducing it into the hold. If cement or other
plugs were used, state the character of same and depth placed, from feet to
feet for each plug set.

Filled hole with Heavy Mud to 860', 60 sacks cement at 860'; Mud to 300', 30 sacks cement
at 300', 1/2 sack Hulls and Howco Plug at 40' with 10 sacks cement. 3 sacks cement in
rat hole, 2 sacks cement in mouse hole.

9-3-80

RECEIVED
STATE CORPORATION COMMISSION
SEP - 3 1980
CONSERVATION DIVISION
Wichita, Kansas

(If additional description is necessary, use BACK of this sheet)
Name of Plugging Contractor STERLING DRILLING COMPANY

STATE OF KANSAS COUNTY OF RICE, ss.
(employee of owner) or (owner or operator)

of the above-described well, being first duly sworn on oath, says: That I have knowledge of
the facts, statements, and matters herein contained and the log of the above-described well
as filed and that the same are true and correct. So help me God.

(Signature) F.A. Wuellner
F.A. Wuellner, Secretary P. O. Box 129

SUBSCRIBED AND SWORN TO before me this 26th day of August, 19 80

CHARLES M. HALL
Rice County, Ks.
My Appt. Exp. Jan. 31, 1982

Charles M. Hall
CHARLES M. HALL Notary Public.

My commission expires

STERLING DRILLING COMPANY
P. O. BOX 129
Sterling, Kansas 67579

WELL LOG ----- SPOMER #1

Located: 660' FML, 1980' FSL SW/4, Section 27-22S-19W
Pawnee County, Kansas

OWNER: Maguire Oil Company
ROTARY DRILLING CONTRACTOR: Sterling Drilling Company

COMMENCED: August 10, 1980
COMPLETED: August 23, 1980

TOTAL DEPTH: 4850'

LOG

0 - 934 Shale
934 - 4850 Lime and Shale

CASING RECORD:

Ran 22 joints; 23 $\frac{3}{4}$ " 8.5/8" OD casing.
919' cemented at 930' K.B. 450 sacks
60/40 Pozmix, 3% cc. Plug down at 3:00
P.M. 8-11-80

DEVIATION SURVEYS:

3/4° at 500'
3/4° at 850'
3/4° at 934'
3/4° at 2274'
1 1/4° at 4390'

PLUGGED AS FOLLOWS:

Mud to 860'. 60 sacks at 860';
Mud to 300'. 30 sacks at 300';
1/2 sack Halls and Howco Plug at 40'
with 10 sacks cement. 3 sacks in rat
hole and 2 sacks in mouse hole. Plug
down at 12:00 P.M. 8-22-80

RECEIVED
STATE CORPORATION COMMISSION
SEP - 2 1980
CONSERVATION DIVISION
Wichita, Kansas