


STATE OF KANSAS
STATE CORPORATION COMMISSION

Give All Information Completely
Make Required Affidavit
Mail or Deliver Report to:
Conservation Division
State Corporation Commission
211 No. Broadway
Wichita, Kansas

WELL PLUGGING RECORD

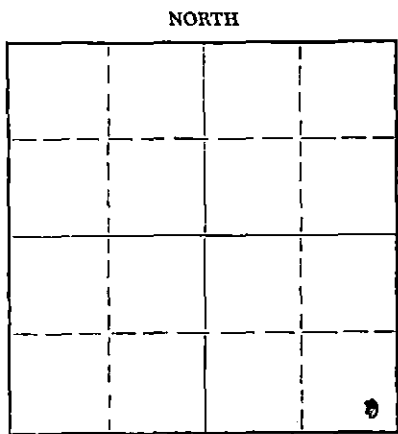

Locate well correctly on above
Section Plat

Pawnee County. Sec. 27 Twp. 22S Rge. (E) 19 (W)
Location as "NE/CNW/SW" or footage from lines 405' WEL & 330' NSL of SE/4
Lease Owner Gulf Oil Corporation
Lease Name A. D. Wells Well No. 1
Office Address Box 661, Tulsa, Oklahoma
Character of Well (completed as Oil, Gas or Dry Hole) Dry Hole
Date well completed 7-5 19 57
Application for plugging filed 7-5 19 57
Application for plugging approved 7-5 19 57
Plugging commenced 7-5 19 57
Plugging completed 7-10 19 57
Reason for abandonment of well or producing formation Dry Hole

If a producing well is abandoned, date of last production 19
Was permission obtained from the Conservation Division or its agents before plugging was commenced? yes

Name of Conservation Agent who supervised plugging of this well R. M. Brundage
Producing formation Dry Hole Depth to top _____ Bottom _____ Total Depth of Well 4785 Feet
Show depth and thickness of all water, oil and gas formations.

OIL, GAS OR WATER RECORDS

CASING RECORD

FORMATION	CONTENT	FROM	TO	SIZE	PUT IN	PULLED OUT
				8-5/8"	535	-0-

Describe in detail the manner in which the well was plugged, indicating where the mud fluid was placed and the method or methods used in introducing it into the hole. If cement or other plugs were used, state the character of same and depth placed, from _____ feet to _____ feet for each plug set.

Filled hole to 800' with mud. Spotted 200 sacks Pozmix cement with 2% calcium chloride through open end drill pipe at 800' which filled hole to 635'. Spotted additional 200 sacks cement through open end drill pipe which filled hole to 435'. Cemented to surface with 145 sacks cement. Capped with 8-5/8" x 2" swage and valve.

NOTE: Attached is Driller's Formation Record which was not available at time Application was submitted.

(If additional description is necessary, use BACK of this sheet)
Name of Plugging Contractor Gabbert-Jones Drilling Company, Inc.
Address 514 Orpheum Building, Wichita, Kansas

STATE OF Kansas, COUNTY OF Sedgwick, ss.
Thomas A. Trax (employee of owner) ~~owner or operator~~ of the above-described well, being first duly sworn on oath, says: That I have knowledge of the facts, statements, and matters herein contained and the log of the above-described well as filed and that the same are true and correct. So help me God.

(Signature) [Signature]
THOMAS A. TRAX
Box 2233, Wichita, Kansas
(Address)

SUBSCRIBED AND SWORN TO before me this 12th day of July, 19 57

My commission expires 2-4-59 Ray W. Rouser 7-18-57
RAY W. ROUSER Notary Public.

RECEIVED
STATE CORPORATION COMMISSION

JRM:RAW

PLUGGING
FILE SEC. 27 T. 22 R. 19W
BOOK PAGE 25 LINE 27

JUL 18 1957

CONSERVATION DIVISION
Wichita, Kansas

