


WELL PLUGGING RECORD

All Information Completely
Required Affidavit
or Deliver Report to:
Conservation Division
State Corporation Commission
211 No. Broadway
Wichita, Kansas

Kingman County. Sec. 36 Twp. 30S Rge. 2W (E) (W)

Location as "NE/CNW/SW" or footage from lines C N/2 NW NW
Lease Owner Pickrell Drilling Company
Lease Name Swingle A Well No. 1
Office Address 705 Fourth Nat'l Bank Bldg. Wichita, Kansas
Character of Well (completed as Oil, Gas or Dry Hole) Oil
Date well completed 19
Application for plugging filed February 26, 1963 19
Application for plugging approved February 27, 1963 19
Plugging commenced March 5, 1963 19
Plugging completed March 11, 1963 19
Reason for abandonment of well or producing formation Dry

NORTH

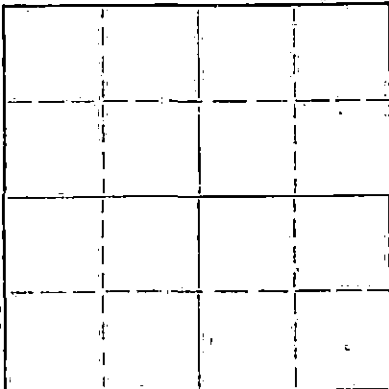

Locate well correctly on above
Section Plat

If a producing well is abandoned, date of last production 19
Was permission obtained from the Conservation Division or its agents before plugging was com-
menced? Yes

Name of Conservation Agent who supervised plugging of this well Archie Elving
Producing formation Depth to top Bottom Total Depth of Well 426 Feet
Show depth and thickness of all water, oil and gas formations.

OIL, GAS OR WATER RECORDS

CASING RECORD

FORMATION	CONTENT	FROM	TO	SIZE	PUT IN	PULLED OUT
				8 5/8	120	none
				5 1/2	none	3812

Describe in detail the manner in which the well was plugged, indicating where the mud fluid was placed and the method or methods used in introducing it into the hole. If cement or other plugs were used, state the character of same and depth placed, from feet to feet for each plug set.

Moved unit on location
Rigged up unit and jacks, measured T.D., worked pipe and shot @ 3832'. Cleaned out cellar.
Worked pipe and shot @ 3732', worked pipe and spotted oil.
Started pipe and pulled pipe.
Pulled pipe.
Pulled rest of pipe. Plugged well @ 150', built 18' rock bridge and dumped 20 sx. cement. Filled hole and rock bridge. Mudded to 30' and capped well with 10 sx. cement

RECEIVED
STATE CORPORATION COMMISSION

MAR 21 1963

CONSERVATION DIVISION
Wichita, Kansas

(If additional description is necessary, use BACK of this sheet)

Name of Plugging Contractor Forbes Casing Pulling, Inc.
Address Box 221 Great Bend, Kansas

STATE OF Kansas COUNTY OF Barton, ss.
J. O. Forbes (employee of owner) or (owner or operator) of the above-described

well, being first duly sworn on oath, says: That I have knowledge of the facts, statements, and matters herein contained and the log of the above-described well as filed and that the same are true and correct. So help me God.

(Signature) J. O. Forbes
Box 221 Great Bend, Kansas (Address)

SUBSCRIBED AND SWORN to before me this 15th day of March, 1963

My commission expires July 23, 1966

Notary Public.

ROTARY DRILLING LOG

15-095-00062-0000

COMPANY: **Pickrell Oil Company, etal**
Wichita, Kansas

LOCATION: **Swingle A-1 C N/2 NW/4 NW/4**
36-308-97, Kingman County, Kansas

CONTRACTOR: **PICKRELL DRILLING COMPANY**
Wichita, Kansas

Rotary Drilling Commenced 1/1/55

Rotary Drilling Completed 1/19/55

CASING RECORD: 120' (3 Jts.) of Armo Spiral Weld 8 5/8" O.D. casing cemented with 125 sacks bulk cement, cement circulated.

189 Jts of 5 1/2" sms 1 1/2 casing set at 4417.22' cemented with 100 sacks bulk cement.

LOG

(Figures indicate bottom of formation - measurements from top of rotary bushing.)

Sand	20	Circ. for samples @	4036
Red bed	240		4312
Red bed, shale & shells	975		4323
Shale Shells	1650		4343
Lime & shale	1815		4415
Lime	1980		4425
Shale	2545		
Lime	2685		
Lime & shale	2790	S.L.M. 1500 - O.K.	
Lime	4190	S.L.M. 3000 - O.K.	
Lime & shale	4238		
Lime	4425	RTD Slope Test 1500 0° off	
		Slope Test 3000 0° off	

RECEIVED
 STATE CORPORATION COMMISSION
 MAR 6 1963
 CONSERVATION DIVISION
 Wichita, Kansas

The undersigned, C. F. Sebitts, Attorney-in-Fact for PICKRELL DRILLING COMPANY, hereby certifies in behalf of said Company, that the above is a true and correct log of the formation encountered in drilling the above well as reflected by the Daily Drilling Reports.

PICKRELL DRILLING COMPANY
 By [Signature]
 Attorney-in-Fact

STATE OF KANSAS, }
 COUNTY OF SEDGWICK } ss.

On this 9th day of February, 1955, before me the undersigned, a Notary Public, in and for the County and State aforesaid, personally appeared C. F. Sebitts

to me known to be the identical person who subscribed the name of PICKRELL DRILLING COMPANY to the foregoing instrument as its Attorney-in-Fact and acknowledged to me that he executed the same as his free and voluntary act and deed, and as the free and voluntary act and deed of such company, for the uses and purposes therein set forth.

Given under my hand and seal of office the day and year last above written.

My Comm. expires July 30, 1950

[Signature]
 Notary Public