


STATE OF KANSAS  
STATE CORPORATION COMMISSION

WELL PLUGGING RECORD

Give All Information Completely  
Make Required Affidavit  
Mail or Deliver Report to:  
Conservation Division  
State Corporation Commission  
211 No. Broadway  
Wichita, Kansas

Kingman County. Sec. 9 Twp. 30S Rge. 10W (E) (W)  
Location as "NE/CNW/SW" or footage from lines Center NW SE  
Lease Owner Bachus Oil Company  
Lease Name THOME Well No. #1  
Office Address 721 East Central, Wichita, Kansas  
Character of Well (completed as Oil, Gas or Dry Hole) Dry Hole  
Date well completed 6-21 1959  
Application for plugging filed 6-20 1959  
Application for plugging approved 6-25 1959  
Plugging commenced 6-22 1959  
Plugging completed 6-22 1959  
Reason for abandonment of well or producing formation No production in commercial quantities  
If a producing well is abandoned, date of last production \_\_\_\_\_ 19\_\_\_\_  
Was permission obtained from the Conservation Division or its agents before plugging was commenced? Yes

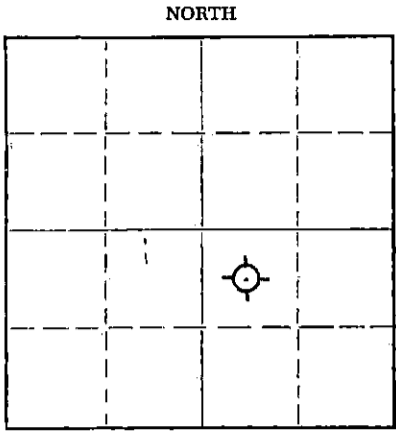

Locate well correctly on above Section Plat

Name of Conservation Agent who supervised plugging of this well Fred W. Hampel  
Producing formation \_\_\_\_\_ Depth to top \_\_\_\_\_ Bottom \_\_\_\_\_ Total Depth of Well 4725 Feet  
Show depth and thickness of all water, oil and gas formations.

OIL, GAS OR WATER RECORDS

CASING RECORD

FORMATION	CONTENT	FROM	TO	SIZE	PUT IN	PULLED OUT
		Surface	Casing	8 5/8"	261'	

Describe in detail the manner in which the well was plugged, indicating where the mud fluid was placed and the method or methods used in introducing it into the hole. If cement or other plugs were used, state the character of same and depth placed, from \_\_\_\_\_ feet to \_\_\_\_\_ feet for each plug set.

Filled hole with heavy mud to 240'. Globe Oil Well Cementing Company set plug with 35 sacks cement @ 240'. Filled hole to 50' with heavy mud and set plug with 15 sacks cement.

6-26-59


RECEIVED  
STATE CORPORATION COMMISSION  
JUN 26 1959  
CONSERVATION DIVISION  
Wichita, Kansas

(If additional description is necessary, use BACK of this sheet)  
Name of Plugging Contractor BACHUS OIL COMPANY  
Address 721 East Central, Wichita, Kansas

STATE OF KANSAS COUNTY OF SEDGWICK, ss.  
Nelson R. Thomas, Geologist (employee of owner) or (owner or operator) of the above-described well, being first duly sworn on oath, says: That I have knowledge of the facts, statements, and matters herein contained and the log of the above-described well as filed and that the same are true and correct. So help me God.

(Signature) Nelson R. Thomas  
Nelson R. Thomas, Geologist  
721 East Central, Wichita, Kansas  
(Address)

SUBSCRIBED AND SWORN to before me this 25th day of June, 19 59

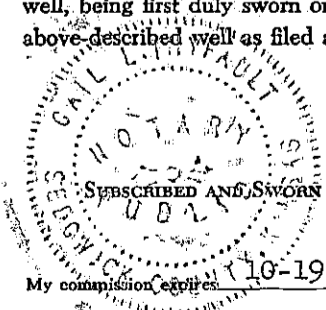

Gail L. Thyfault  
Gail L. Thyfault Notary Public.

PLUGGING  
FILE SEQ 9 T 30 R 10W  
BOOK PAGE 46 LINE 44