

STATE OF KANSAS
STATE CORPORATION COMMISSION

Give All Information Completely
Make Required Affidavit
Mail or Deliver Report to:
Conservation Division
State Corporation Commission
212 No. Market
Wichita, Kansas

WELL PLUGGING RECORD

Pawnee County, Sec. 15 Twp. 22S Rge. 17W (E) (W)
Location as "NE/CNW&SW" or footage from lines SW SW NW

Lease Owner Vincent Oil Company

Lease Name Rost WD Well No. 1

Office Address 625 Union Center Building

Character of Well (completed as Oil, Gas or Dry Hole) Dry Hole

Date well completed 11-12 19 69

Application for plugging filed 11-12 19 69

Application for plugging approved 11-12 19 69


Plugging commenced 11-12 19 69

Plugging completed 11-12 19 69

Reason for abandonment of well or producing formation Dry Hole

If a producing well is abandoned, date of last production _____ 19 _____

Was permission obtained from the Conservation Division or its agents before plugging was commenced? Yes

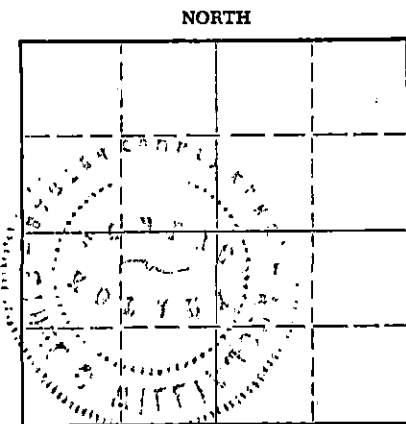

Locate well correctly on above Section Plat

Name of Conservation Agent who supervised plugging of this well Leo F. Massey

Producing formation _____ Depth to top _____ Bottom _____ Total Depth of Well _____ Feet

Show depth and thickness of all water, oil and gas formations.

OIL, GAS OR WATER RECORDS

CASING RECORD

FORMATION	CONTENT	FROM	TO	SIZE	PUT IN	PULLED OUT

Describe in detail the manner in which the well was plugged, indicating where the mud fluid was placed and the method or methods used in introducing it into the hole. If cement or other plugs were used, state the character of same and depth placed, from _____ feet to _____ feet for each plug set.

~~XXXX~~

4214 - 300 - Heavy rotary mud
 300 - 300 - Plug, 25 sacks cement
 300 - 40 - Heavy rotary mud
 40 - GL - Plug, 10 sacks cement
 2 sacks cement in rat hole

RECEIVED
NOV 25 1969
STATE CORPORATION COMMISSION
CONSERVATION DIVISION
Wichita, Kansas

(If additional description is necessary, use BACK of this sheet)

Name of Plugging Contractor Peel Brothers, Inc.
Address Box 359, Hoisington, Kansas 67544

STATE OF Kansas COUNTY OF Barton, ss.

Peel Brothers, Inc. (employee of owner) or (owner) of the above-described well, being first duly sworn on oath, says: That I have knowledge of the facts, statements, and matters herein contained and the log of the above-described well as filed and that the same are true and correct. So help me God.

(Signature) Wendell C. Peel

Wendell C. Peel, President
(Address)

SUBSCRIBED AND SWORN TO before me this 14th day of November, 1969

My commission expires 6-21-70

Ethel S. Williamson
Ethel S. Williamson Notary Public.

WELL LOG BUREAU KANSAS GEOLOGICAL SOCIETY
412 Union National Bldg., Wichita, Kansas

Company AMERADA PETROLEUM CORP.
Farm - Frank B. Odell No. 1

SEC. 15 T. 22 R. 17W
S77 SW NW

Total Depth, 4326'
Comm. 12-21-48 Comp. 1-11-49
Shot or Treated.
Contractor, Beardmore Drilling Co.
Issued, 2-19-49

County, Pawnee KANSAS



CASING:
8 5/8" 1045 w/450 ax

Elevation, _____

Production, Dry

Figures indicate Bottom of Formations.

sand	15
clay	70
shale, shells	465
sand, clay	600
iron	680
shale	775
shale, shells	780
sand, shale	990
anhydrite	1060
red rock shale	1200
shale, shells	1480
shale, limo	1935
limo	2035
limo, brkn	2140
limo	2205
shale, shells	2310
limo	2340
shale, limo	2490
limo, shale	2580
limo	2630
limo, shale	2780
shale, limo	2085
limo	3140
lime brkn	3255
limo, shale	3635
lime	4035
shale	4050
lime, chert	4065
conglomerate of chert	4090
chert	4099
lime, chert	4135
limo, shale, chert	4155
limo, shale	4240
limo, shale, sand	4270
limo, shale	4326
Total depth	

F. BECKER
PETROLEUM GEOLOGIST
419 FIRST NATIONAL BANK BLDG.
WICHITA, KANSAS 67202

RECEIVED
STATE CORPORATION COMMISSION
NOV 25 1969
CONSERVATION DIVISION
Wichita, Kansas

Tops:

Kochbror	3533
Lansing	3636
Viola	4090
Simpson	4150
Arucklo	4185