


STATE OF KANSAS
STATE CORPORATION COMMISSION
CONSERVATION DIVISION
P. O. BOX 17027
WICHITA, KANSAS 67217

FORM CP-4

WELL PLUGGING RECORD

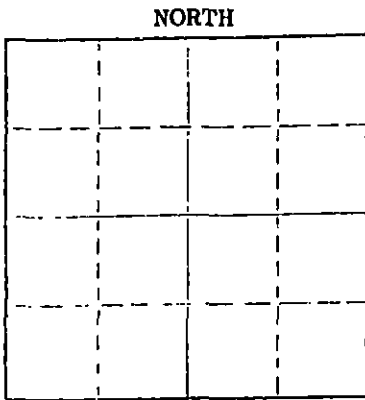

Locate well correctly on above Section Plat

Pawnee County, Sec. 16 Twp. 22S Rge. 17W (E) (W)
Location as "NE/CNW&SW4" or footage from lines C SE/4
Lease Owner Wayne L. Kirkman
Lease Name Bayer Well No. 1
Office Address Box 18148 Wichita, Kansas
Character of Well (completed as Oil, Gas or Dry Hole) Gas
Date well completed 19
Application for plugging filed 7/11/75 19
Application for plugging approved 7/12/75 19
Plugging commenced 7/11/75 19
Plugging completed 7/15/75 19
Reason for abandonment of well or producing formation Depleted

If a producing well is abandoned, date of last production 19
Was permission obtained from the Conservation Division or its agents before plugging was commenced? yes

Name of Conservation Agent who supervised plugging of this well Leo Massey
Producing formation _____ Depth to top _____ Bottom _____ Total Depth of Well 3195 Feet
Show depth and thickness of all water, oil and gas formations.

OIL, GAS OR WATER RECORDS

CASING RECORD

FORMATION	CONTENT	FROM	TO	SIZE	PUT IN	PULLED OUT
				8 5/8	294'	none
				5 1/2	3193'	1634.93'

Describe in detail the manner in which the well was plugged, indicating where the mud fluid was placed and the method or methods used in introducing it into the hole. If cement or other plugs were used, state the character of same and depth placed, from _____ feet to _____ feet for each plug set.

Shot well at 2130 feet Solid Cement
Shot well at 1707-1683-1657-1637 feet Recovered 1634.93 feet 5 1/2 casing
Mixed 20 sax of gel and 50 sax of cement. Pulled pipe up to 250 feet and pumped 5 sax of gel and 100 sax of cement. Came out of hole and pumped 50 sax of cement.

(If additional description is necessary, use BACK of this sheet)

Name of Plugging Contractor Dunbar Drilling Inc.
Address 5252 North Broadway Wichita, Kansas 67219

STATE OF Kansas COUNTY OF Sedgwick ss.
W. P. Simmons (employee of owner) or (owner/operator) of the above-described well, being first duly sworn on oath, says: That I have knowledge of the facts, statements, and matters herein contained and the log of the above-described well as filed and that the same are true and correct. So help me God.

(Signature) W. P. Simmons
5252 North Broadway Wichita, Ks. 67219
(Address)

Subscribed and sworn to before me this first day of August, 1975

My commission expires Nov. 19, 1977
Frances J. Simmons Notary Public.



RECEIVED
STATE CORPORATION COMMISSION

AUG 4 1975 8-4-75

CONSERVATION DIVISION
Wichita, Kansas

WOODMAN & IANNITTI DRILLING COMPANY

15-145-20307-0000

Rotary Drilling Contractors

1008 UNION NATIONAL BUILDING
WICHITA, KANSAS 67202

October 23, 1973

Company;:	Wayne L. Kirkman
Farm;	#1 Bayer Unit
Location;	C SE/4
Section;	16-22-17W
County;	Pawnee
Contractor;	Woodman & Iannitti Drilling Co.
Comm;	October 10, 1973
Compl;	October 19, 1973
Total Depth;	3195'
Casing;	8 5/8" @ 294' w/225 sacks 5 1/2" @ 3193'

Figures Indicate Bottom Formations:

100	Clay & Sand
250	Shale & Sand Streaks
295	Shale
375	Shale
500	Shale & Red Bed
630	Sand
700	Shale & Sand
786	Shale
1070	Shale & Red Bed
1110	Anhy
1350	Shale & Shells
1740	Shale & Shells
2020	Shale & Lime
2115	Lime & Shale
2133	Lime
2175	Lime
2325	Lime & Shale
2595	Lime
2715	Lime
2815	Shale & Lime
2995	Shale & Lime
3105	Lime
3195	Lime & Shale

RECEIVED
STATE CORPORATION COMMISSION

JUL 3 1975

CONSTRUCTION DIVISION

Woodman & Iannitti Drlg. Co.

K. T. Woodman