


STATE OF KANSAS  
STATE CORPORATION COMMISSION

Form CP-4

Give All Information Completely  
Make Required Affidavit  
Mail or Deliver Report to:  
Conservation Division  
State Corporation Commission  
212 No. Market  
Wichita, Kansas 67202

15-009-03087-0000  
WELL PLUGGING RECORD

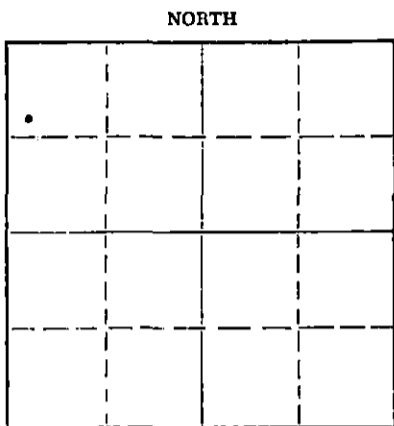

Locate well correctly on above Section Plat

Barton County. Sec. 27 Twp. 16 Rge. (E) 11 (W)  
Location as "NE/CNW/SW" or footage from lines SW NW NW  
Lease Owner Hinkle Oil Company  
Lease Name Willenberg Well No. 3  
Office Address 1016 Union Center, Wichita, Kansas  
Character of Well (completed as Oil, Gas or Dry Hole) oil  
Date well completed \_\_\_\_\_ 19\_\_\_\_  
Application for plugging filed December 24 19 69  
Application for plugging approved \_\_\_\_\_ 19\_\_\_\_  
Plugging commenced January 2 19 70  
Plugging completed January 28 19 70  
Reason for abandonment of well or producing formation depleted

If a producing well is abandoned, date of last production \_\_\_\_\_ 19\_\_\_\_  
Was permission obtained from the Conservation Division or its agents before plugging was commenced? yes

Name of Conservation Agent who supervised plugging of this well Donald Truan  
Producing formation \_\_\_\_\_ Depth to top \_\_\_\_\_ Bottom \_\_\_\_\_ Total Depth of Well 3355 Feet  
Show depth and thickness of all water, oil and gas formations.

OIL, GAS OR WATER RECORDS

CASING RECORD

FORMATION	CONTENT	FROM	TO	SIZE	PUT IN	PULLED OUT
		0	115'	10 3/4"	115'	none
		0	3353'	5 1/2"	3353'	1717.71

Describe in detail the manner in which the well was plugged, indicating where the mud fluid was placed and the method or methods used in introducing it into the hole. If cement or other plugs were used, state the character of same and depth placed, from \_\_\_\_\_ feet to \_\_\_\_\_ feet for each plug set.

Sanded back to 3330' and dumped 5 sacks of cement.  
Squeezed well with 20 sacks mud and 100 sacks of cement.

RECEIVED  
STATE CORPORATION COMMISSION  
FEB 4 1970 02.04.70  
CONSERVATION DIVISION  
Wichita, Kansas

(If additional description is necessary, use BACK of this sheet)  
Name of Plugging Contractor PIPE PULLERS, INC.  
Address Box 486, Ellinwood, Kansas

STATE OF Kansas, COUNTY OF Barton, ss.  
Evelyn Roth (employee of owner) or (owner/operator) of the above-described well, being first duly sworn on oath, says: That I have knowledge of the facts, statements, and matters herein contained and the log of the above-described well as filed and that the same are true and correct. So help me God.

(Signature) Evelyn Roth  
Ellinwood, Kansas  
(Address)

SUBSCRIBED AND SWORN TO before me this 3 day of February, 19 70

My commission expires July 7, 1972

[Signature]  
Notary Public.


WELL LOG BUREAU---KANSAS GEOLOGICAL SOCIETY  
412 Union National Bk. Bldg., Wichita, Kansas

Company - HINKLE OIL CO. & GULF OIL CORP.,  
Farm - Willenberg No. 3

SEC. 27 T. 16 R. 11 W  
SW NW NW

Total Depth. 3355'  
Comm. 7-11-45 Comp. 9-8-45  
Shot or Treated. 9-5-45 500 gals.  
Contractor.  
Issued. 10-15-45

County. Barton  
KANSAS

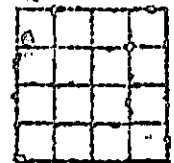

Elevation. \_\_\_\_\_

Production. Drawdown Pot. 970 B.  
no wtr.

CASING:

10 3/4" 115' Cem. LI  
5 1/2" 3353' Cem. LI

Figures Indicate Bottom of Formations.

shale	0-115
shale & shells	275
sand	345
shale & shells	485
shale	495
lime	525
shale & shells	740
anhydrite lime	770
shale & shells	1755
lime	1995
lime brkn	2070
lime	2110
lime & shale	2475
lime	2490
lime & shale	2610
lime	2666
lime & shale	2745
lime	3004
lime & shale	3038
lime	3353
Arbuckle lime	3355
Total Depth.	

Tops:

Lansing-Kans. City	3058
Marmaton	3330
Pennsylvanian	
conglomerate lime	3334
Conglomerate	3342
Arbuckle dolomite	3351

RECEIVED  
STATE CORPORATION COMMISSION  
DEC 29 1969  
CONSERVATION DIVISION  
Wichita, Kansas