

STATE OF KANSAS
STATE CORPORATION COMMISSION
200 Colorado Derby Bldg.
Wichita, Kansas 67202

Form CP-4
Rev. 12-15-80

WELL PLUGGING RECORD

Give All Information Completely
Make Required Affidavit

COUNTY Kingman SEC. 10 TWP. 30S RGE. 10W E/W
Location as in quarters or footage from lines:

80' W of C S/2 NE

Locate Well
correctly on above
Section Platt.

Lease Owner Raymond Oil Company, Inc.
Lease Name Katzer Well No. #1
Office Address One Main Place Suite 900 Wichita, Kansas 67202
Character of Well (Completed as Oil, Gas or Dry Hole): _____
Date Well Completed _____
Application for plugging filed _____
Plugging commenced 7-30-81
Plugging completed 8-6-81
Reason for abandonment of well or producing formation _____

Depleted
Was permission obtained from the Conservation Division or it's
Agent's before plugging was commenced? yes

Name of Conservation Agent who supervised plugging of this well Maurice V. Leslie
Producing formation _____ Depth to top _____ bottom _____ T.D. 3370'

Show depth and thickness of all water, oil and gas formations.

OIL, GAS OR WATER RECORDS

Casing Record

Formation	Content	From	To	Size	Put in	Pulled Out
				8-5/8"	259'	none
				4-1/2"	3217'	2286'

Describe in detail the manner in which the well was plugged, indicating where the mud fluid was placed and the method or methods used in introducing it into the hold. If cement or other plugs were used, state the character of same and depth placed, from _____ feet to _____ feet for each plug set.

Moved on location, ran sand to 3100' and set 4 sacks cement, had 19" stretch. Shot pipe @2618', 2498', 2418', and 2298'. Layed down 57 joints. Plugged well with 6 sacks gel, 2 sacks hulls and 100 sacks cement. Plugging Completed.

(If additional description is necessary, use BACK of this sheet)

Name of Plugging Contractor Kelso Casing Pulling


STATE OF Kansas COUNTY OF Rice, ss.
R. Darrell Kelso (employee of owner) or (owner or operator) of the above-described well, being first duly sworn on oath, says: That I have knowledge of the facts, statements, and matters herein contained and the log of the above-described well as filed and that the same are true and correct. So help me God.

(Signature) R. Darrell Kelso
R. Darrell Kelso
(Address)

SUBSCRIBED AND SWORN TO before me this 7th day of August

RECEIVED
STATE CORPORATION COMMISSION
AUG 12 1981

My Commission expires:

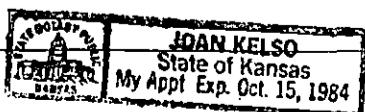

CONSERVATION DIVISION
Wichita, Kansas

8-12-81

WELL LOG

COMPANY Raymond Oil Company

SEC. 10 T. 30S R. 10W

FARM Katzer NO. 1

LOC. S/2 NE


TOTAL DEPTH 3218

COUNTY Kingman

COMM. 7-24-79 COMP. 7-31-79

CONTRACTOR DaMac Drilling Inc.

CASING 8 5/8 set @ 259

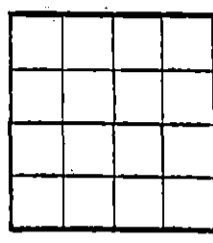

ELEVATION

PRODUCTION 4 1/2 set @ 3217

FIGURES INDICATE BOTTOM OF FORMATIONS

Sand, RedBed	0	260
Shale	260	441
RedBed, Shale	441	1650
Shale	1650	2120
Lime, Shale	2120	3218 RTD

7-9-81

RECEIVED STATE CORPORATION COMMISSION

AUG - 9 1981

CONSERVATION DIVISION Wichita, Kansas

State of Kansas
County of Barton

I, Martha J. McKown of DaMac Drilling Inc.

upon oath state the above and foregoing is a true and correct copy of the log of the Katzer No. 1 well.

Martha J. McKown

Subscribed and sworn to before me this 3rd day of August 1979

My Commission Expires: 4-28-81

STATE NOTARY PUBLIC
LANA L. REMMERT
Barton County, Kansas
My Appl. Exp. 4-28-81

Lana L. Remmert
NOTARY PUBLIC