


STATE OF KANSAS  
STATE CORPORATION COMMISSION

Form CP-4

Give All Information Completely  
Make Required Affidavit  
Mail or Deliver Report to:  
Conservation Division  
State Corporation Commission  
P. O. Box 17027  
Wichita, Kansas 67217  
NORTH

WELL PLUGGING RECORD

Kingman County. Sec. 10 Twp. 30S Rge. (E) 10W  
Location as "NE/CNW/SW" or footage from lines C NE SE  
Lease Owner Mack Oil Co.  
Lease Name Sheperd Well No. 1  
Office Address 812 Union Center, Wichita, KS 67202  
Character of Well (completed as Oil, Gas or Dry Hole) dry hole  
Date well completed 5-17-74 19  
Application for plugging filed 5-29-74 19  
Application for plugging approved 5-17-74 19  
Plugging commenced 5-17-74 19  
Plugging completed 5-17-74 19  
Reason for abandonment of well or producing formation dry hole

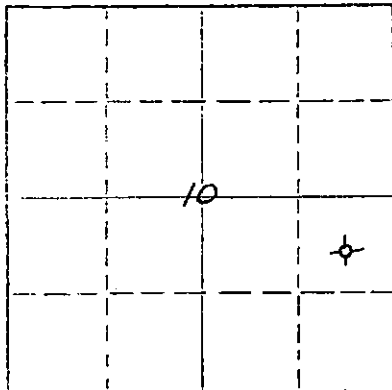

Locate well correctly on above Section Plat

If a producing well is abandoned, date of last production 19  
Was permission obtained from the Conservation Division or its agents before plugging was commenced? YES

Name of Conservation Agent who supervised plugging of this well G. R. Biberstein, Attica, KS  
Producing formation Depth to top Bottom Total Depth of Well 4700 Feet  
Show depth and thickness of all water, oil and gas formations.

OIL, GAS OR WATER RECORDS

CASING RECORD

FORMATION	CONTENT	FROM	TO	SIZE	PUT IN	PULLED OUT
				8 5/8"	258'	

Describe in detail the manner in which the well was plugged, indicating where the mud fluid was placed and the method or methods used in introducing it into the hole. If cement or other plugs were used, state the character of same and depth placed, from feet to feet for each plug set.

Plugged @ 250' w/35 sx. cement  
40' w/15 sx. cement

Rec'd 5-30-74


(If additional description is necessary, use BACK of this sheet)  
Name of Plugging Contractor Thomas Drilling Co.  
Address P. O. Box 400, Duncan, OK 73533

STATE OF Kansas COUNTY OF Sedgwick, ss.  
Harry A. Larsh (employee of owner) or (owner or operator) of the above-described

well, being first duly sworn on oath, says: That I have knowledge of the facts, statements, and matters herein contained and the log of the above well as filed and that the same are true and correct. So help me God.

(Signature) Harry A. Larsh  
812 Union Center, Wichita, KS 67202 (Address)

SUBSCRIBED AND SWORN to before me this 29th day of May, 1974  
My Commission Expires Jan. 8, 1978  
Nancy Laggart Notary Public.

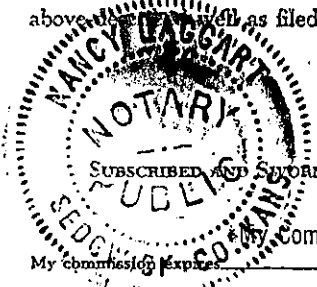

MACK OIL COMPANY  
Duncan, Oklahoma  
73533

DRILLERS WELL LOG

#1 Sheperd C NE SE - Section 10-30S-10W  
Kingman County, Kansas  
Commenced R. D. 5-9-74 Elevation: 1745' KB, 1738' GL  
Completed R. D. 5-17-74 Dry & Abandoned  
Rotary Total Depth: 4700' Contractor: Thomas Drilling Co.

STRATA	DEPTH
Redbed	0 - 870
Shale & Shells	870 - 1655
Lime	1655 - 2147
Shale & Lime	2147 - 2415
Lime	2415 - 2620
Shale & Lime	2620 - 2720
Lime	2720 - 3558
Shale & Lime	3558 - 3775
Lime	3775 - 4700 RTD

RECEIVED  
STATE CORPORATION COMMISSION  
MAY 30 1974  
CONSERVATION DIVISION  
Wichita, Kansas

I hereby certify that the above is a true and correct log of said well as reflected by the daily drilling reports.

MACK OIL CO.

BY Harry A. Larsh  
Harry A. Larsh

Signed and sworn to in my presence  
this 29th day of May, 1974, by  
Harry A. Larsh, representative of  
Mack Oil Co.....

Nancy Laggart  
Nancy Laggart, Notary Public

My Commission Expires Jan. 8, 1978

