


STATE OF KANSAS  
STATE CORPORATION COMMISSION  
200 Colorado Derby Bldg.  
Wichita, Kansas 67202

Form CP-4  
Rev. 12-15-80

WELL PLUGGING RECORD

Give All Information Completely  
Make Required Affidavit

COUNTY Hodgeman SEC. 31 TWP. 22S RGE. 22W E/W  
Location as in quarters or footage from lines:  
C SE SW

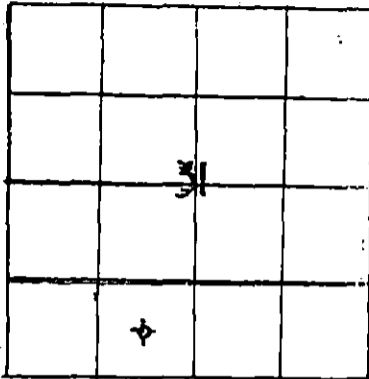

Locate Well  
correctly on above  
Section Platt.

Lease Owner Mid-Continent Energy Corp.  
Lease Name Good Earth Ranch Well No. 1  
Office Address 712 - 120 Bldg., Wichita, Ks. 67202  
Character of Well (Completed as Oil, Gas or Dry Hole): dry hole  
Date Well Completed April 23, 1983  
Application for plugging filed April 23, 1983  
Plugging commenced April 23, 1983  
Plugging completed April 23, 1983  
Reason for abandonment of well or producing formation dry hole

Was permission obtained from the Conservation Division or it's  
Agent's before plugging was commenced? Yes

Name of Conservation Agent who supervised plugging of this well Paul Luthi  
Producing formation \_\_\_\_\_ Depth to top \_\_\_\_\_ bottom T.D. 4500'

Show depth and thickness of all water, oil and gas formations.

OIL, GAS OR WATER RECORDS

Casing Record

Formation	Content	From	To	Size	Put in	Pulled Out
	Surface			8 5/8"	1385	-0-

Describe in detail the manner in which the well was plugged, indicating where the mud  
fluid was placed and the method or methods used in introducing it into the hold. If cement  
or other plugs were used, state the character of same and depth placed, from \_\_\_\_\_ feet  
to \_\_\_\_\_ feet for each plug set.

Plugged through drill pipe @ 1430' w/ 50 sx.;  
@ 680' w/40 sx.; 10 sx. & a bridge @ 40'; 10 sx. in rathole  
w/50/50 posmix, 4% gel.

(If additional description is necessary, use BACK of this sheet)

Name of Plugging Contractor B & B Drilling, Inc.

STATE OF KANSAS COUNTY OF SEDGWICK, ss.

Larry P. Schneider (employee of owner) or (owner or operator) of the  
above-described well, being first duly sworn on oath, says: That I have knowledge of the  
facts, statements, and matters herein contained and the log of the above-described well as  
filed and that the same are true and correct. So help me God.

MID-CONTINENT ENERGY CORP.  
X(Signature) [Signature]  
712-120 Bldg., Wichita, Ks. 67202  
(Address)

SUBSCRIBED AND SWORN TO before me this 28th day of April, 19 83

My Commission expires: \_\_\_\_\_



Mary Kathleen Bachman  
Notary Public.  
RECEIVED  
STATE CORPORATION COMMISSION

APR 29 1983

CONSERVATION DIVISION  
Wichita, Kansas