

62

STATE OF KANSAS  
STATE CORPORATION COMMISSION


Form CP-4

Give All Information Completely  
Make Required Affidavit  
Mail or Deliver Report to:  
Conservation Division  
State Corporation Commission  
211 No. Broadway  
Wichita, Kansas

WELL PLUGGING RECORD

Hodgeman County. Sec. 30 Twp. 22S Rge. 22W (E) (W)  
Location as "NE/CNW/SW" or footage from lines C NW NW  
Lease Owner Adair Oil Company  
Lease Name Housman Well No. 1  
Office Address 1005 East Second, Wichita, Kansas  
Character of Well (completed as Oil, Gas or Dry Hole) Dry Hole  
Date well completed September 2, 1965  
Application for plugging filed September 2, 1965  
Application for plugging approved September 2, 1965  
Plugging commenced September 2, 1965  
Plugging completed September 2, 1965  
Reason for abandonment of well or producing formation D & A

NORTH

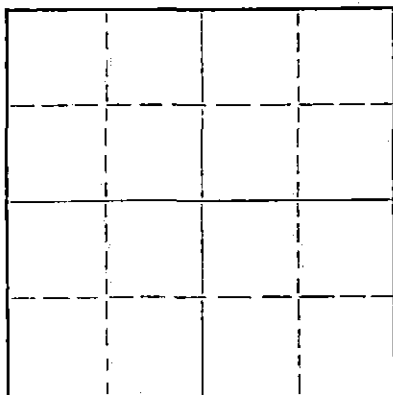

Locate well correctly on above  
Section Plat

If a producing well is abandoned, date of last production 19  
Was permission obtained from the Conservation Division or its agents before plugging was commenced? Yes

Name of Conservation Agent who supervised plugging of this well Hugh E. Scott  
Producing formation \_\_\_\_\_ Depth to top \_\_\_\_\_ Bottom \_\_\_\_\_ Total Depth of Well 4570 Feet  
Show depth and thickness of all water, oil and gas formations.

OIL, GAS OR WATER RECORDS

CASING RECORD

FORMATION	CONTENT	FROM	TO	SIZE	PUT IN	PULLED OUT
				8 5/8"	301'	-0-

Describe in detail the manner in which the well was plugged, indicating where the mud fluid was placed and the method or methods used in introducing it into the hole. If cement or other plugs were used, state the character of same and depth placed, from \_\_\_\_\_ feet to \_\_\_\_\_ feet for each plug set.

Filled hole w/mud to 700', set plug,  
1/2 sack hulls, 25 sacks cement. Filled  
hole w/mud up to 325', set plug, 25 sacks  
cement. Filled hole w/mud up to 45', set  
plug, 15 sacks cement. 2 sacks in rathole.

RECEIVED  
STATE CORPORATION COMMISSION

SEP 14 1965

CONSERVATION DIVISION  
Wichita, Kansas

9-14-65

(If additional description is necessary, use BACK of this sheet)  
Name of Plugging Contractor Red Tiger Drilling Company  
Address Box 173 -- Russell, Kansas

STATE OF KANSAS COUNTY OF SEDGWICK, ss.  
Maxine V. Head (employee of owner) or (~~owner or operator~~) of the above-described well; being first duly sworn on oath, says: That I have knowledge of the facts, statements, and matters herein contained and the log of the above-described well as filed and that the same are true and correct. So help me God.

(Signature) Maxine V. Head  
1720 Wichita Plaza, Wichita, Kansas  
(Address)

SUBSCRIBED AND SWORN TO before me this 7th day of September, 19 65

My commission expires

5-22-66

Notary Public.

RP

DRILLERS LOG

Housman No. 1

CASING RECORD: 8 5/8" @ 301' w/225 sx cement  
 COMPANY: Adair Oil Company  
 CONTRACTOR: Red Tiger Drilling Company  
 COMMENCED: August 23, 1965  
 COMPLETED: September 2, 1965  
 DESCRIPTION: C NW NW  
 30-22S-22W  
 Hodgeman Co., Ks.  
 ELEVATION: 2297 DF  
 2300 RB  
 TOTAL DEPTH: 4570'

<u>FORMATION</u>	<u>FROM</u>	<u>TO</u>	<u>REMARKS</u>
Lime & Shale	0	65	
Shale & Shells	65	175	
Shale & Redbed	175	305	
Shale	305	580	
Redbed	580	625	
Redbed & Shale	625	950	
Sand	950	1110	
Redbed & Shale	1110	1447	
Anhydrite	1447	1490	
Shale & Shells	1490	2270	
Shale & Lime	2270	4015	
Lime	4015	4510	
Lime & Chert	4510	4548	
Mississippian Chert	4548	4570	

RECEIVED  
 STATE CORPORATION COMMISSION  
 SEP 14 1965  
 CONSERVATION DIVISION  
 Wichita, Kansas

I certify that this is a true and correct copy of the above log to the best of my knowledge.

RED TIGER DRILLING COMPANY

Maxine V. Head  
 Maxine V. Head

Subscribed and sworn to before me this 7th day of September, 1965.

Jean Hollan  
 Notary Public

My Commission Expires:

5-22-66