


STATE OF KANSAS
STATE CORPORATION COMMISSION
CONSERVATION DIVISION
P. O. BOX 17027
WICHITA, KANSAS 67217

FORM CP-4

WELL PLUGGING RECORD

Hodgeman County, Sec. 36 Twp. 22S Rge. (E) 22(W)

Location as "NE/CNW/SE/SW" or footage from lines C SE SE
Lease Owner O. A. Sutton
Lease Name Korf Well No. 1
Office Address 800 Sutton Place, Wichita, Kansas 67202
Character of Well (completed as Oil, Gas or Dry Hole) Dry Hole
Date well completed September 4 1976
Application for plugging filed September 4 1976
Application for plugging approved September 4 1976
Plugging commenced September 4 1976
Plugging completed September 4 1976
Reason for abandonment of well or producing formation

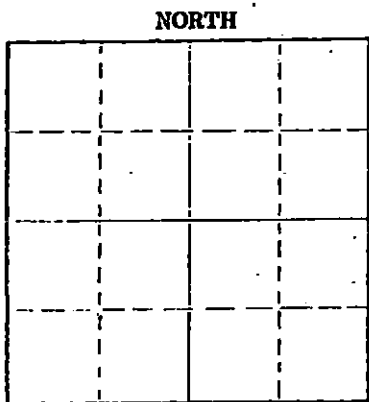

Locate well correctly on above Section Plat

If a producing well is abandoned, date of last production 19
Was permission obtained from the Conservation Division or its agents before plugging was commenced? Yes

Name of Conservation Agent who supervised plugging of this well Clarence Thomas
Producing formation Depth to top Bottom Total Depth of Well 4562 Feet
Show depth and thickness of all water, oil and gas formations.

OIL, GAS OR WATER RECORDS

CASING RECORD

FORMATION	CONTENT	FROM	TO	SIZE	PUT IN	PULLED OUT
				8-5/8"	337'	

Describe in detail the manner in which the well was plugged, indicating where the mud fluid was placed and the method or methods used in introducing it into the hole. If cement or other plugs were used, state the character of same and depth placed, from feet to feet for each plug set.

Plug at 900' with 50 sacks; plug at 330' with 35 sacks; plug at 40' with 15 sacks. 5 sacks in rat hole. Job complete at 12:30 9-4-76. Job by Halliburton. 9-21-76

RECEIVED
STATE CORPORATION COMMISSION
SEP 21 1976


(If additional description is necessary, use BACK of this sheet)
Name of Plugging Contractor Gabbert-Jones, Inc. CONSERVATION DIVISION
Address 830 Sutton Place, Wichita, Kansas 67202 WICHITA, KANSAS

STATE OF KANSAS COUNTY OF SEDGWICK
Jack G. Paulsen (employee of owner) or (owner or operator) of the above-described

well, being first duly sworn on oath, says: That I have knowledge of the facts, statements, and matters herein contained and the log of the above-described well as filed and that the same are true and correct. So help me God.

(Signature) Jack G. Paulsen
800 Sutton Place, Wichita, Kansas 67202 (Address)

Subscribed and Sworn to before me this 20th day of September 1976

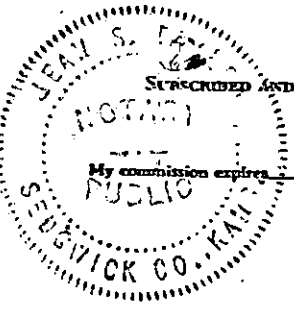

My commission expires June 28, 1978.

Jean S. Taylor Notary Public

GABBERT-JONES, INC.
 WICHITA, KANSAS
 DRILLERS' WELL LOG

Korf #1
 SE SE Sec 36-22S-22W
 Hodgeman County Kansas

Commenced: 8-24-76

Completed: 9-4-76

OPERATOR: O. A. SUTTON

Depth		Formation	Remarks
From	to		
0	100	Surface Clay- Post Rock	Ran 8 jts. of used 8 5/8" csg set @ 237' Cemented w/ 200 sks Common 2% Gel 3% CC PD @ 12:05 a.m. 8-25-76
100	341	Shale-w/sand stks	
341	395	Shale	
395	885	Shale-Redbed	
885	1095	Sand	
1095	1200	Shale	
1200	1435	Shale-Sand	
1435	1467	Anhy	
1467	1965	Shale	
1965	2285	Shale-Lime	
2285	4176	Lime-Shale	
4176	4562	Lime	
	4562 - TD		DRY & ABANDONED

SEP 21 1976

CONSERVATION DEPARTMENT
 WICHITA, KANSAS

STATE OF KANSAS)
) SS
 COUNTY OF SEDGWICK)

I, the undersigned, being duly sworn on oath, state that the above Drillers Log is true and correct to the best of my knowledge and belief and according to the records of this office.

GABBERT-JONES, INC.

James S. Sutton II
 JAMES S. SUTTON II

Subscribed and sworn to before me this 10th day of September, 1976.

Elizabeth J. Edwards
 ELIZABETH J. EDWARDS-NOTARY PUBLIC

