


STATE OF KANSAS
STATE CORPORATION COMMISSION

Form CP-4

Give All Information Completely
Make Required Affidavit
Mail or Deliver Report to:
Conservation Division
State Corporation Commission

WELL PLUGGING RECORD

P. O. Box 17027
Wichita, Kansas 67217
NORTH

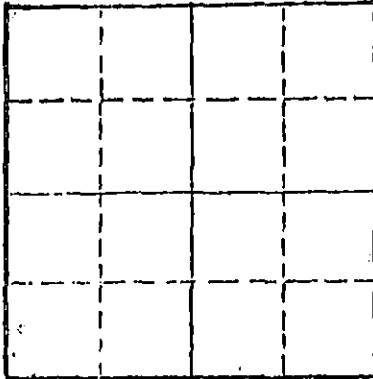

Locate well correctly on above
Section Plot

Pawnee County, Sec. 31 Twp. 22 Rge. 17 (E) (W)
Location as "NE/CNWSW" or footage from lines C BL 23/4
Lease Owner Addis Oil Operations
Lease Name Porteous #2 Well No.
Office Address Wichita, Kansas 67208
Character of Well (completed as Oil, Gas or Dry Hole)
Date well completed 10
Application for plugging filed 10
Application for plugging approved 10
Plugging commenced 1/27/74 10
Plugging completed 2/2/74 10
Reason for abandonment of well or producing formation depleted.

If a producing well is abandoned, date of last production 10
Was permission obtained from the Conservation Division or its agents before plugging was commenced? yes

Name of Conservation Agent who supervised plugging of this well Massey
Producing formation Depth to top Bottom Total Depth of Well 4340 Feet
Show depth and thickness of all water, oil and gas formations.

OIL, GAS OR WATER RECORDS

CASING RECORD

FORMATION	CONTENT	FROM	TO	SIZE	PUT IN	PULLED OUT
				8-5/8	270	none
				5 1/2"	4339	3013'

Describe in detail the manner in which the well was plugged, indicating where the mud fluid was placed and the method or methods used in introducing it into the hole. If cement or other plugs were used, state the character of same and depth placed, from feet to feet for each plug set.

Checked hole to 4340' and ran sand to 4260', ran 4 sacks cement. Loaded hole with 2 loads of water, shot pipe at 3201', 3109', 3014', pulled 95 joints. Allied pumped 3 sacks hulls, 20 sacks gel and 100 sacks cement.

PLUGGING COMPLETE.

RECEIVED
STATE CORPORATION COMMISSION
MAR 13 1974
CONSERVATION DIVISION
Wichita, Kansas

(If additional description is necessary, use BACK of this sheet)
Name of Plugging Contractor KNIGHT CASING PULLING CO., INC.
Address CHASE, KANSAS

STATE OF KANSAS COUNTY OF RICE
NOEL J. KNIGHT (employee of owner) or (owner or operator) of the above-described well, being first duly sworn on oath, says: That I have knowledge of the facts, statements, and matters herein contained and the log of the above-described well as filed and that the same are true and correct. So help me God.

(Signature) Noel Knight
CHASE, KANSAS (Address)

Subscribed and Sworn to before me this 7th day of Feb, 1974

My commission expires Feb. 15, 1975
MARGARET MELCHER
NOTARY PUBLIC
Rice County, Kansas

Margaret Melcher
Notary Public.