


STATE OF KANSAS
STATE CORPORATION COMMISSION
CONSERVATION DIVISION
P. O. BOX 17027
WICHITA, KANSAS 67217

WELL PLUGGING RECORD

Pawnee County, Sec. 31 Twp 22S Rge (E) 17 (W)
Location as "NE/CNW/SW" or footage from lines E/2 E/2 NE
Lease Owner Little George Oil Co.
Lease Name Welch Well No. 2-A
Office Address 225 Sutton Place - Wichita, Ks.
Character of Well (completed as Oil, Gas or Dry Hole) Oil
Date well completed 9-15-55 19
Application for plugging filed 6-7-74 19
Application for plugging approved 6-12-74 19
Plugging commenced 9-6-74 19
Plugging completed 9-20-74 19
Reason for abandonment of well or producing formation Reservoir depleted
If a producing well is abandoned, date of last production 12-31-73 19
Was permission obtained from the Conservation Division or its agents before plugging was commenced? Yes

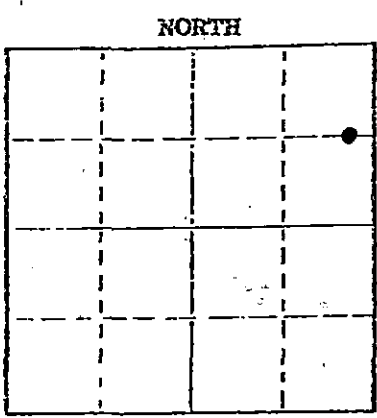

Locate well correctly on above Section Plat

Name of Conservation Agent who supervised plugging of this well Dale Balthazar
Producing formation Conglom. sand Depth to top 4239 Bottom 4245 Total Depth of Well 4290
Show depth and thickness of all water, oil and gas formations.

OIL, GAS OR WATER RECORDS

CASING RECORD

FORMATION	CONTENT	FROM	TO	SIZE	PUT IN	PULLED OUT
Conglomerate sand	oil	4239	4245	5 1/2	4289	3367
				8 5/8	200	None

RECEIVED
STATE CORPORATION COMMISSION
OCT 21 1974
CONSERVATION DIVISION
Wichita, Kansas

Describe in detail the manner in which the well was plugged indicating where the mud fluid was placed and the method or methods used in introducing it into the hole. If cement or other plugs were used, state the character of same and depth placed, from feet to feet for each plug set.

Fill with sand to 4100 and cap with 4 sx cement. Fill casing with water. Shoot off 5 1/2" at 3367'. Pull 103 joints. Install plug retainer on 8 5/8". Plug with 2 sacks hulls, 20 sx gel, 1 sack hulls. Release plug and cement with 100 sacks 50-50 Poz mix cement, 6% gel. Plug down 11:15 a.m. 9-20-74.

Name of Plugging Contractor Kathol Petroleum, Inc.
Address 230 Sutton Place - Wichita, Kansas 67202

STATE OF Kansas COUNTY OF Sedgwick
Donald J. Malone (employee of owner) or (owner or operator) of the above-described

well, being first duly sworn on oath, says: That I have knowledge of the facts, statements, and matters herein contained and the log of the above-described well as filed and that the same are true and correct. So help me God.

(Signature) Donald J. Malone
225 Sutton Place - Wichita, Ks. 67202
(Address)

Sworn to before me this 17 day of October 1974
Barbara B. Brittain
Notary Public.

