


STATE OF KANSAS  
STATE CORPORATION COMMISSION

Form CP-4

Give All Information Completely  
Make Required Affidavit  
Mail or Deliver Report to:  
Conservation Division  
State Corporation Commission

P. O. Box 17027  
Wichita, Kansas 67217  
NORTH

WELL PLUGGING RECORD

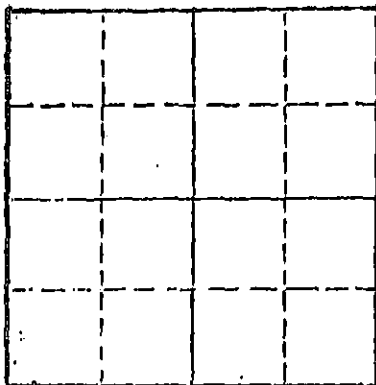

Locate well correctly on above  
Section Plat

Pawnee County, Sec 32 Twp 22 Rge 17 (E) (W)  
Location as "NE/CNW/SE/SW" or footage from lines NW NW SW  
Lease Owner: Addis Oil Operations  
Lease Name: Jordaan #1 Well No.  
Office Address: Wichita, Kansas  
Character of Well (completed as Oil, Gas or Dry Hole)  
Date well completed 19\_\_  
Application for plugging filed 19\_\_  
Application for plugging approved 19\_\_  
Plugging commenced 1/22/74 19\_\_  
Plugging completed 2/2/74 19\_\_  
Reason for abandonment of well or producing formation depleted

If a producing well is abandoned, date of last production 19\_\_  
Was permission obtained from the Conservation Division or its agents before plugging was commenced? yes

Name of Conservation Agent who supervised plugging of this well Massey  
Producing formation Depth to top Bottom Total Depth of Well 4303 Feet  
Show depth and thickness of all water, oil and gas formations.

OIL, GAS OR WATER RECORDS

CASING RECORD

| FORMATION | CONTENT | FROM | TO | SIZE   | PUT IN | PULLED OUT |
|-----------|---------|------|----|--------|--------|------------|
|           |         |      |    | 8-5/8  | 217    | none       |
|           |         |      |    | 5 1/2" | 4300   | 2601'      |
|           |         |      |    |        |        |            |
|           |         |      |    |        |        |            |
Describe in detail the manner in which the well was plugged, indicating where the mud fluid was placed and the method or methods used in introducing it into the hole. If cement or other plugs were used, state the character of same and depth placed, from feet to feet for each plug set.

Checked hole to 4303', ran sand to 4200' and ran 4 sacks cement.  
Loaded hole with water, shot pipe at 3216', 3118', 2820', 2709',  
2606', 3007', 2820', 2709', 2606', pulled 82 joints.  
Pumped 3 sacks bulls, 20 gel and 100 cement.

PLUGGING COMPLETE.

RECEIVED  
STATE CORPORATION COMMISSION  
MAR 1 1 1974  
CONSERVATION DIVISION  
Wichita, Kansas

(If additional description is necessary, use BACK of this sheet)  
Name of Plugging Contractor: KNIGHT CASING PULLING CO., INC.  
Address: CHASE, KANSAS

STATE OF KANSAS COUNTY OF RICE ss.

NOEL J. KNIGHT (employee of owner) or (owner or operator) of the above-described well, being first duly sworn on oath, says: That I have knowledge of the facts, statements, and matters herein contained and the log of the above-described well as filed and that the same are true and correct. So help me God.

(Signature) Noel Knight  
Chase, Kansas  
(Address)

Subscribed and Sworn to before me this 20th day of February 10 74

My commission expires  
MARGARET MELCHER  
NOTARY PUBLIC  
Rice County, Kansas  
My Commission Expires Feb. 15

Margaret Melcher  
Notary Public