

STATE OF KANSAS
STATE CORPORATION COMMISSION
CONSERVATION DIVISION
P. O. BOX 17027
WICHITA, KANSAS 67217

FORM CP-4

WELL PLUGGING RECORD

Pawnee County, Sec 32 Twp 22S Rge (E) 17 (W)

Location as "NE/CNWSW" or footage from lines S/2 S/2 NW

Lease Owner Little George Oil Co.

Lease Name Welch Well No. 3-B

Office Address 225 Sutton Place - Wichita, Ks.

Character of Well (completed as Oil, Gas or Dry Hole) Oil

Date well completed 2-15-56 19

Application for plugging filed 6-7-74 19

Application for plugging approved 6-11-74 19


Plugging commenced 9-23-74 19

Plugging completed 9-27-74 19

Reason for abandonment of well or producing formation Reservoir depleted

If a producing well is abandoned, date of last production 6-1-74 19

Was permission obtained from the Conservation Division or its agents before plugging was commenced? Yes

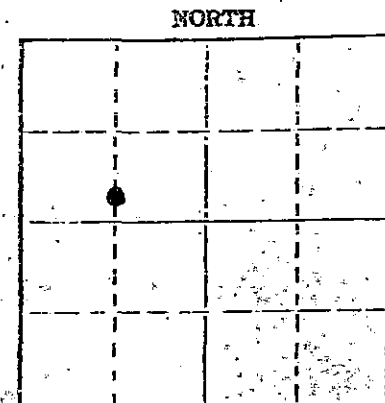

Locate well correctly on above Section Plat

Name of Conservation Agent who supervised plugging of this well Dale Balthazer

Producing formation Conglomerate Sd Depth to top 4108 Bottom 4247 Total Depth of Well 4261

Show depth and thickness of all water, oil and gas formations.

OIL, GAS OR WATER RECORDS

CASING RECORD

FORMATION	CONTENT	FROM	TO	SIZE	PUT IN	PULLED OUT
Conglomerate Sand	Oil	4108	4247	5 1/2	4261	2675
				8 5/8	242	None

Describe in detail the manner in which the well was plugged, indicating where the mud fluid was placed and the method or methods used in introducing it into the hole. If cement or other plugs were used, state the character of same and depth placed, from _____ feet to _____ feet for each plug set.

Fill with sand to 3800' and cap with 4 sacks common cement. Fill with water. Shoot off 5 1/2" at 3020', 2860', 2700' and 2675'. Pull 83 joints. Install plug retainer on 8 5/8". Plug well with 2 sacks hulls, 20 sacks gel, 1 sack hulls. Release plug and cement with 100 sacks 50-50 Poz Mix Cement, 6% gel. Plug down 9:45 p.m. 9-26-74.

RECEIVED
STATE CORPORATION COMMISSION
OCT 21 1974
CONSERVATION DIVISION
Wichita, Kansas

Name of Plugging Contractor Kathol Petroleum, Inc.
Address 230 Sutton Place, Wichita, Kansas 67202

STATE OF Kansas COUNTY OF Sedgwick

Donald J. Malone (employee of owner) or (owner or operator) of the above-described well, being first duly sworn on oath, says: That I have knowledge of the facts, statements, and matters herein contained and the log of the above-described well as filed and that the same are true and correct. So help me God.

(Signature) Donald J. Malone
225 Sutton Place, Wichita, Ks. 67202
(Address)

Subscribed and Sworn to before me this 17 day of October 1974



March 1, 1978
Barbara B. Britain
Notary Public.

WELCH #3
 OWNER: EARL F. WAKEFIELD &
 C. I. ROSS
 CONTRACTOR: EARL F. WAKEFIELD
 COMD: 12/21/55 COMP: 1/5/56

G S/2 S/2 NW/4
 32 22 17W
 PAWNEE COUNTY, KANSAS
 CASING 8 5/8" set @ 242'
 9 1/2" set @ 4261'

ELEVATION: 2071 D.F.
 2073 R.R.

RECEIVED
 STATE CORPORATION COMMISSION
 JUN 12 1954
 CONSERVATION DIVISION
 Wichita, Kansas

Surface	246
Shale & Shells	460
Sand & Shale	550
Sand	650
Shale & Sand	950
Shale & Red Bed	1100
Lime	1145
Lime & Shale	1300
Shale & Shells	1850
Lime & Shale	3715
Lime	3730
Lime & Shale	3775
Lime	3905
Shale & Lime	3975
Lime	4017
Lime & Shale	4125
Conglomerate	4169
Shale & Sand	4190
Shale & Conglomerate	4210
Shale, Chert & Conglo:	4230
Lime	4262
Total Rotary Depth	4262

STATE OF KANSAS)
) SS
 COUNTY OF SEDGWICK)

I hereby agree and certify that the above is a true and correct copy of the log on the Welch #3 well located G S/2 S/2 NW/4 32-22-17W, Pawnee County, Kansas.

Earl F. Wakefield
 Earl F. Wakefield

Sworn and subscribed before this 18th day of January, 1956.

C. A. Snow
 C. A. Snow

My commission expires July 26, 1958.