

WELL PLUGGING RECORD

Give All Information Completely
Make Required Affidavit
Mail or Deliver Report to:
Conservation Division
State Corporation Commission
211 No. Broadway
Wichita, Kansas

Pawnee

County, Sec. 32 Twp. 22 Rge. 17 (~~29~~) (W)

Location as "NE/CNW/SW" or footage from lines SW SW SW SE

Lease Owner Welch & Olsson Drilling Co. Inc.

Lease Name Klepper Well No. B-1

Office Address 203 Rule Bldg. Wichita, Ks.

Character of Well (completed as Oil, Gas or Dry Hole) Dry Hole

Date well completed 10-15 19 56

Application for plugging filed 10-15 19 56

Application for plugging approved 10-15 19 56


Plugging commenced 10-15 19 56

Plugging completed 10-15 19 56

Reason for abandonment of well or producing formation Dry Hole

If a producing well is abandoned, date of last production None 19

Was permission obtained from the Conservation Division or its agents before plugging was commenced? Yes

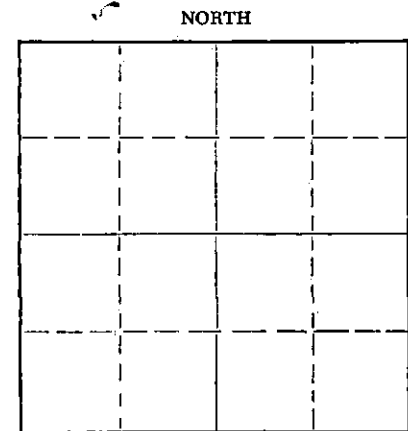

Locate well correctly on above Section Plat

Name of Conservation Agent who supervised plugging of this well R. M. Brundage, Box 283, Hoisington, Ks.

Producing formation Depth to top Bottom Total Depth of Well 4222 Feet

Show depth and thickness of all water, oil and gas formations.

OIL, GAS OR WATER RECORDS

CASING RECORD

| FORMATION | CONTENT | FROM | TO | SIZE | PUT IN | PULLED OUT |
|-----------|---------|------|----|-------|--------|------------|
| | | | | 8 5/8 | 196.40 | None |
| | | | | | | |
| | | | | | | |
| | | | | | | |
| | | | | | | |
| | | | | | | |
| | | | | | | |
| | | | | | | |

Describe in detail the manner in which the well was plugged, indicating where the mud fluid was placed and the method or methods used in introducing it into the hole. If cement or other plugs were used, state the character of same and depth placed, from feet to feet for each plug set.

Cemented with 100 sacks of cement with Service Truck

Name of Plugging Contractor Welch & Olsson Drilling Co. Inc. (If additional description is necessary, use BACK of this sheet)
Address 203 Rule Bldg. Wichita, Ks.

STATE OF Kansas COUNTY OF Sedgwick, ss.
R. E. Welch (owner or operator) of the above-described

well, being first duly sworn on oath, says: That I have knowledge of the facts, statements, and matters herein contained and the log of the above-described well as filed and that the same are true and correct. So help me God.

(Signature) [Signature]

203 Rule Bldg. Wichita, Ks. (Address)

SUBSCRIBED AND SWORN TO before me this 23 day of October, 19 56

My commission expires June 12, 1959

[Signature]
Edith Erby, Notary Public.
STATE CORPORATION COMMISSION

PLUGGING
FILE SEC. 32 T. 22 R. 17W
BOOK PAGE 107 LINE 45

OCT 24 1956 10-24-56
CONSERVATION DIVISION
Wichita, Kansas

WELL LOG.

WELCH & OLSSON DRILLING CO. INC.

ELEVATION: 2065 R.B.

CONTRACTOR: WELCH & OLSSON DRILLING CO. INC.

COMMENCED: 10-3-56

KLEPPER B-1

COMPL. DRLG. 10-15-56

SW SW SW Sec. 32, Twp. 22, Rge. 17W
Pawnee County, Kansas.

PRODUCTION: B & A.

Casing Record.

Set 196.40' of 8 5/8" with 175 sacks of cement.

(Figures indicate bottom of formations.)

FORMATIONS:

DEPTHS

FORMATION TOPS.

| | | | |
|-----------------------|------|----------------------|--------------|
| Shale: | 310 | Heebner: | 3595 (-1530) |
| Sand: | 317 | Brown Lime: | 3697 (-1632) |
| Shale: | 365 | Lansing-Kansas City: | 3706 (-1641) |
| Red Bed & Shale: | 555 | Shaley-Conglomerate: | 4118 (-2053) |
| Sand: | 620 | Conglomerate Sand: | 4129 (-2064) |
| Red Bed & Shale: | 1093 | Cherty Conglomerate: | 4156 (-2091) |
| Anhydrite: | 1118 | Viola: | 4213 (-2148) |
| Shale & Shells: | 1775 | | |
| Shale & Lime Streaks: | 1800 | | |
| Shale & Lime: | 2850 | | |
| Shale & Lime Streaks: | 3050 | | |
| Shale & Lime: | 3600 | | |
| Lime: | 4130 | | |
| Lime, Chert & Shale: | 4212 | | |
| Lime: | 4222 | | |

STATE OF KANSAS,)
) SS:
SEDGWICK COUNTY,)

I hereby certify that the above is a true and correct copy of Drillers Log of well drilled in the SW SW SW of Section 32, Township 22, Range 17 West, Pawnee County, Kansas.

WELCH & OLSSON DRILLING COMPANY, INC.

BY *R. E. Welch*
R. E. WELCH

Subscribed and sworn to before me this 23rd day of October, 1956.

Edith Erker
Edith Erker, Notary Public.

My commission expires:
June 12, 1959

PLUGGING
FILE SEC. 32 T. 22 R. 17W
BOOK PAGE 107 LI. E. 45

RECEIVED
OCT 24 1956
SERVATION DIVISION
Wichita, Kansas