

STATE OF KANSAS  
STATE CORPORATION COMMISSION


Form CP-4

WELL PLUGGING RECORD

Give All Information Completely,  
Make Required Affidavit  
Mail or Deliver, Report to:  
Conservation Division  
State Corporation Commission  
212 No. Market  
Wichita, Kansas 67202

Pawnee County, Sec. 22 Twp. 22 Rge. 17 (E) (W)

Location as "NE/CNW/SW" or footage from lines SW SW SW  
Lease Owner Fender Pipe & Supply  
Lease Name Ohnmacht #1 Well No.  
Office Address Russell, Kansas 67665  
Character of Well (completed as Oil, Gas or Dry Hole)  
Date well completed 19  
Application for plugging filed 19  
Application for plugging approved 19  
Plugging commenced 8/31/70 19  
Plugging completed 9/2/70 19  
Reason for abandonment of well or producing formation depleted.

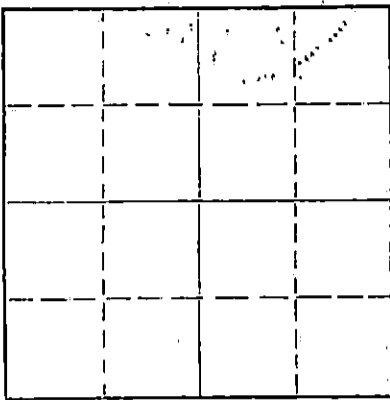

Locate well correctly on above  
Section Plat

If a producing well is abandoned, date of last production 19  
Was permission obtained from the Conservation Division or its agents before plugging was commenced? yes

Name of Conservation Agent who supervised plugging of this well Massey  
Producing formation Depth to top Bottom Total Depth of Well 4190 Feet  
Show depth and thickness of all water, oil and gas formations.

OIL, GAS OR WATER RECORDS

CASING RECORD

FORMATION	CONTENT	FROM	TO	SIZE	PUT IN	PULLED OUT
				8-5/8	1032	none
				4 1/2"	4189	1993'

Describe in detail the manner in which the well was plugged, indicating where the mud fluid was placed and the method or methods used in introducing it into the hole. If cement or other plugs were used, state the character of same and depth placed, from feet to feet for each plug set.

Checked hole to 4190', ran sand to 4000' and ran 3 sacks of cement.  
Loaded hole with water, shot pipe at 2703', 2612', 2482', 2380', 2320',  
2255', 2187', 2122', 2063', 2000', pulled 62 joints. Set rock bridge  
at 350' and ran 5 yards concrete. Talled pipe.

PLUGGING COMPLETE.


RECEIVED  
STATE CORPORATION COMMISSION  
SEP 9 1970  
CONSERVATION DIVISION  
Wichita, Kansas

(If additional description is necessary, use BACK of this sheet)  
Name of Plugging Contractor KNIGHT CASING PULLING CO., INC.  
Address CHASE, KANSAS

STATE OF KANSAS, COUNTY OF RICE, ss.  
NOEL J. KNIGHT (employee of owner) or (owner or operator) of the above-described well, being first duly sworn on oath, says: That I have knowledge of the facts, statements, and matters herein contained and the log of the above-described well as filed and that the same are true and correct. So help me God.

(Signature) Noel Knight  
CHASE, KANSAS

SUBSCRIBED AND SWORN to before me this 3rd day of Sept., 1970

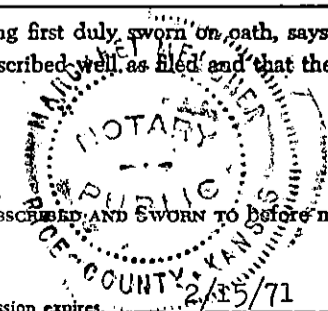

My commission expires 2/15/71  
Margaret Mulches  
Notary Public.