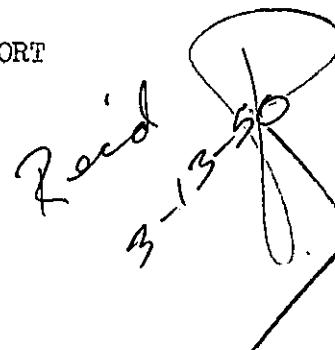


## DISTRICT CONSERVATION AGENT'S REPORT

TO:


State Corporation Commission  
 Conservation Division  
 800 Bitting Building  
 Wichita, Kansas

FILE NO. 142-32LOCATION SE NW NESEC. 2 TWP. 14 RGE. 15Dry Hole        Abandoned Oil Well X Abandoned Gas Well       

I have today completed supervision of plugging of:

Well No. 5 Lease JohnsonOperator The Texas Co Address Wichita, KansField Gorham County RussellTotal Depth 3140 Feet.

(Describe briefly the manner in which the well was plugged)

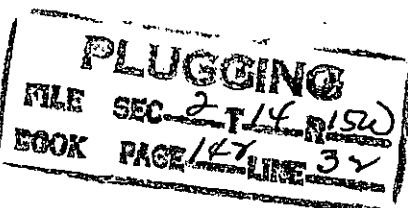8 5/8" at 2540', 7" at 3058',Filled with mud and chat to 3050', run 4 sax cement with dumpbailer, pulled 2985' of 7" and approx 500' of 8 5/8",filled hole with heavy mud to 125', set rock bridge and 25 saxcement, filled with heavy mud to 30', set rock bridge and15 sax cement to bottom cellar.

District Conservation Agent

Date 4-26-50