

STATE OF KANSAS  
STATE CORPORATION COMMISSION

Form CP-4

WELL PLUGGING RECORD

Give All Information Completely  
Make Required Affidavit  
Mail or Deliver Report to:  
Conservation Division  
State Corporation Commission  
212 No. Market  
Wichita, Kansas

Russell County, Sec. 2 Twp. 14S Rge. 15 (E) W (W)

Location as "NE/CNW/SW" or footage from lines NE NE NE

Lease Owner Leo J. Dreiling Oil Co.

Lease Name Johnson "H" Well No. #1

Office Address R. R. #2 ; Victoria, Kansas 67671

Character of Well (completed as Oil, Gas or Dry Hole) \_\_\_\_\_

Date well completed \_\_\_\_\_ 19\_\_

Application for plugging filed July 1970

Application for plugging approved \_\_\_\_\_ 19\_\_


Plugging commenced July 29 1970

Plugging completed July 31 1970

Reason for abandonment of well or producing formation \_\_\_\_\_

If a producing well is abandoned, date of last production \_\_\_\_\_ 19\_\_

Was permission obtained from the Conservation Division or its agents before plugging was commenced? YES

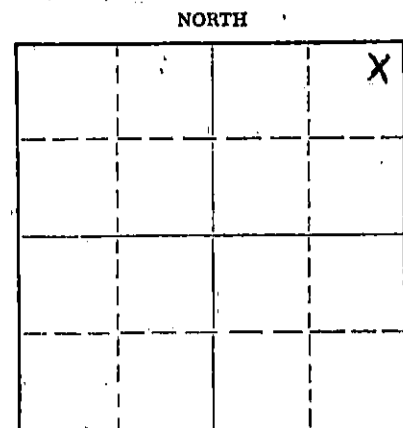

Locate well correctly on above  
Section Plat

Name of Conservation Agent who supervised plugging of this well Leo Massey

Producing formation \_\_\_\_\_ Depth to top \_\_\_\_\_ Bottom \_\_\_\_\_ Total Depth of Well \_\_\_\_\_ Feet

Show depth and thickness of all water, oil and gas formations.

OIL, GAS OR WATER RECORDS

CASING RECORD

FORMATION	CONTENT	FROM	TO	SIZE	PUT IN	PULLED OUT
				8 5/8"	942	None
				5 1/2"	3311	2585

Describe in detail the manner in which the well was plugged, indicating where the mud fluid was placed and the method or methods used in introducing it into the hole. If cement or other plugs were used, state the character of same and depth placed, from \_\_\_\_\_ feet to \_\_\_\_\_ feet for each plug set.

July 29, 1970 Plugged off bottom. Dumped sand to 3050'. Mixed and dumped 5 sx of cement.

July 31, 1970 Plugged off top. Set 10' rock bridge from 315' to 325'. Filled 8 5/8" surface casing with ready-mix concrete, from 315' to base of cellar.

RECEIVED  
STATE CORPORATION COMMISSION  
AUG 17 1970  
CONSERVATION DIVISION  
Wichita, Kansas

Name of Plugging Contractor RUSS CASING PULLING, INC.  
Address P. O. BOX 1082 ; GREAT BEND, KANSAS 67530


STATE OF \_\_\_\_\_, COUNTY OF \_\_\_\_\_, ss.

\_\_\_\_\_  
(employee of owner) or (owner or operator) of the above-described well, being first duly sworn on oath, says: That I have knowledge of the facts, statements, and matters herein contained and the log of the above-described well as filed and that the same are true and correct. So help me God.

(Signature) Leo J. Dreiling

(Address) \_\_\_\_\_

SUBSCRIBED AND SWORN to before me this 10 day of AUGUST, 1970

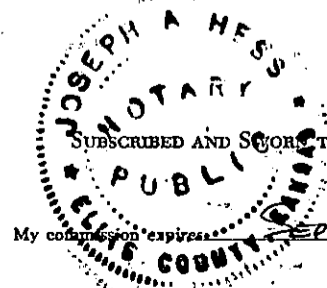

My commission expires SEPT 19, 1970  
\_\_\_\_\_  
Notary Public.

L. J. DREILING and SONS, Inc.  
VICTORIA, KANSAS

WELL LOG

Company: Leo J. Dreiling Oil Company  
 Victoria, Kansas  
 Farm: H. Johnson No. 1  
 Total Depth: 3316'  
 Comm: 4/6/64 Comp: 4/13/64  
 Contractor: L. J. DREILING & SONS, INC.  
 VICTORIA, KANSAS

STATE CORPORATION COMMISSION  
 RECEIVED  
 JUL 31 1970  
 CONSERVATION DIVISION  
 Wichita, Kansas

Sec. 2 Twp. 14 Rng. 15  
 Location NE NE NE  
 County Russell County  
 Elevation: D. F.  
 G. R.

Casing Record	Cement Record	Production:
920' - - - 8 5/8"	400 sacks cement	Arbuckle
3314' - - - 5 1/2"	175 sacks cement	

Figures Indicate Bottom of Formations

0 - 50	Clay
50 - 850	Sand & Shale
850 - 920	Shale
920 - 963	Anhydrite
963 - 1120	Shale
1120 - 1845	Shale
1845 - 2042	Shale & Lime
2042 - 2255	Shale
2255 - 2495	Shale
2495 - 2925	Shale & Lime
2925 - 3086	Lime
3086 - 3110	Lime
3110 - 3248	Lime
3248 - 3303	Lime
3303 - 3316	Lime
3316	TD

STATE OF KANSAS )  
 ) ss.  
 COUNTY OF ELLIS )

I, Leo F. Dreiling, of the L. J. Dreiling & Sons, Inc., upon oath states that the above and foregoing is a true and correct copy from the Daily Drilling Report from your H. Johnson #1.

*Leo F. Dreiling*  
 LEO F. DREILING

Subscribed and sworn to before me this 19th day of April, 1964.

*Ormel Zimmerman*  
 NOTARY PUBLIC

My Commission Expires: August 14, 1965