


STATE OF KANSAS
STATE CORPORATION COMMISSION

WELL PLUGGING RECORD

Give All Information Completely
Make Required Affidavit
Mail or Deliver Report to
Conservation Division
State Corporation Comm.
245 North Water
Wichita, KS 67202

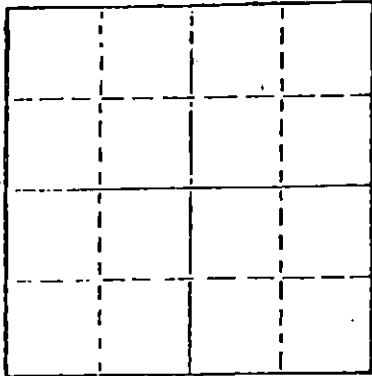

Locate well correctly on above
Section Plot

Russell County, Sec. 2 Twp. 14 Rge. 15 E/W
Location as "NE/CNW $\frac{1}{4}$ SW $\frac{1}{4}$ " or footage from lines
C W/2 SW

Lease Owner Hawkins Energy Company
Lease Name Sullivan Well No. 1
Office Address 514 Professional Building, Independence, Ks.
Character of Well (Completed as Oil, Gas or Dry Hole)
Dry Hole

Date Well completed August 19 19 76
Application for plugging filed August 19 19 76
Application for plugging approved August 19 19 76
Plugging commenced August 19 19 76
Plugging completed August 19 19 76

Reason for abandonment of well or producing formation
Dry Hole

If a producing well is abandoned, date of last production
19

Was permission obtained from the Conservation Division or
its agents before plugging was commenced? yes

Name of Conservation Agent who supervised plugging of this well Duane Rankin
Producing formation _____ Depth to top _____ Bottom _____ Total Depth of Well 3350
Show depth and thickness of all water, oil and gas formations.

OIL, GAS OR WATER RECORDS

CASING RECORD

FORMATION	CONTENT	FROM	TO	SIZE	PUT IN	PULLED OUT

Describe in detail the manner in which the well was plugged, indicating where the mud fluid was placed and the method or methods used in introducing it into the hold. If cement or other plugs were used, state the character of same and depth placed, from _____ feet to _____ feet for each plug set.

Bottom plug @ 550' w/40 sacks cement thru drill pipe.
Middle plug @ 285' w/20 sacks cement thru drill pipe.
Top plug @ 40' w/ $\frac{1}{2}$ sack hulls and 10 sacks cement.
2 sacks cement in rat hole

RECEIVED
STATE CORPORATION COMMISSION
AUG 24 1976
CONSERVATION DIVISION
Wichita, Kansas

(If additional description is necessary, use BACK of this sheet)

Name of Plugging Contractor Duke Drilling Co.

STATE OF KANSAS COUNTY OF BARTON, ss.
Leonard Williamson (employee of owner) or ~~(STATE REPRESENTATIVE)~~

of the above-described well, being first duly sworn on oath, says: That I have knowledge of the facts, statements, and matters herein contained and the log of the above-described well as filed and that the same are true and correct. So help me God.

(Signature) Leonard Williamson
Box 823, Great Bend, Kansas 67530
(Address)

SUBSCRIBED AND SWORN TO before me this 20th day of August, 1976

Dorothy M. Haque
Notary Public.

My commission expires April 11, 1978

DRILLERS' WELL LOG

DATE COMMENCED: August 10, 1976
 DATE COMPLETED: August 19, 1976

Hawkins Energy Company
 "SULLIVAN #.1"
 C W/2 SW/4
 Sec 2-T14S-R15W
 Russell County, Kansas

ELEVATION: 1871 K.B.

0 - 287' Surface Soil, Post Rock, Shale
 287 - 350' Shale, Shells
 350 - 906' Red Bed, Shale
 906 - 944' Anhydrite
 944 - 2750' Shale and Lime
 2750 - 2761' Shale
 2761 - 2985' Lime
 2985 - 2989' Shale
 2989 - 3004' Shale, Lime
 3004 - 3016' Lime
 3016 - 3039' Shale and Lime
 3039 - 3265' Lime
 3265 - 3292' Lime, Shale
 3292 - 3342' Sand
 3342 - 3350' Quartzite
 3350' RTD

FORMATION DATA

Anhydrite	906
Severy	2750
Topeka	2761
Heebner	2985
Toronto	3004
Douglas	3016
Kansas City	3039
Base K.C.	3265
Gorham Sand	3292
Granite Wash	3342
RTD	3350

SURFACE PIPE:

Set used 28#, 8 5/8" pipe at
 285' w/160 sacks Common,
 2% Gel, 3% cc.

A F F I D A V I T

STATE OF KANSAS }
 COUNTY OF BARTON } ss.

Leonard Williamson, of lawful age, does swear and state that the facts and statements herein contained are true and correct to the best of his knowledge.

Leonard Williamson

Subscribed and sworn to before me this 20th day of August, 1976.

Douglas M. Hague
 Notary Public

My Commission Expires: April 11, 1978

RECEIVED
 STATE CORPORATION COMMISSION

AUG 24 1976

CONSERVATION DIVISION
 Wichita, Kansas