


WELL PLUGGING RECORD

Give All Information Completely
 Make Required Affidavit

API NO.: 15-095-21,399-0000

COUNTY Kingman SEC. 31 TWP. 30S RGE. 10W E/W
 Location as in quarters or footage from lines:
200' S of Cen. NE-SW

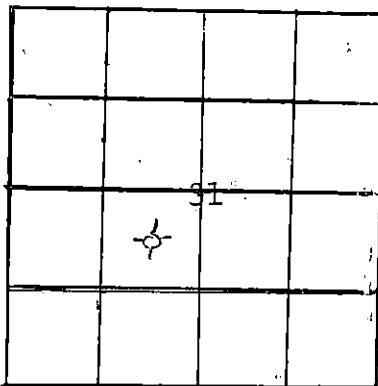

Locate Well
 correctly on above
 Section Platt.

Lease Owner F&M Oil Company, Inc.
 Lease Name Mease Well No. 1
 Office Address 422 Union Center Bldg., Wichita, Ks.67202
 Character of Well (Completed as Oil, Gas or Dry Hole) Dry Hole
 Date Well Completed 11-11-83
 Application for plugging filed (Verbally) 11-30-83
(Approved)
 Plugging commenced 11-11-83
 Plugging completed 11-11-83
 Reason for abandonment of well or producing formation _____

Was permission obtained from the Conservation Division or it's
 Agent's before plugging was commenced? Yes

Name of Conservation Agent who supervised plugging of this well _____

Producing formation _____ Depth to top _____ bottom _____ T.D. 3860'

Show depth and thickness of all water, oil and gas formations.

OIL, GAS OR WATER RECORDS

Casing Record

Formation	Content	From	To	Size	Put in	Pulled Out
Soil, Sand & Redbed	Surface	0	375	8-5/8"	275'	None

Describe in detail the manner in which the well was plugged, indicating where the mud
 fluid was placed and the method or methods used in introducing it into the hold. If cement
 or other plugs were used, state the character of same and depth placed, from _____ feet
 to _____ feet for each plug set.

35 Sacks Cement at 330'
Bridge Plug & 35 Sacks Cement at 60'
25 Sacks Cement in Rat Hole

(If additional description is necessary, use BACK of this sheet)

Name of Plugging Contractor Brandt Drilling Co., Inc.
1200 Douglas Bldg., Wichita, Kansas 67202

STATE OF KANSAS COUNTY OF SEDGWICK, ss. *Brandt Drilling Co., Inc.
Timothy E. Brandt, VP & Gen. Mgr.* (employee of owner) or (owner or operator) of the
 above-described well, being first duly sworn on oath, says: That I have knowledge of the
 facts, statements, and matters herein contained and the log of the above-described well as
 filed and that the same are true and correct. So help me God.

(Signature) [Signature]
1200 Douglas Building
 (Address)
Wichita, Kansas 67202

Geraldine T. Rowland
 NOTARY PUBLIC
 SEDGWICK COUNTY, KANSAS
 MY APPT. EXP. _____

SUBSCRIBED AND SWORN TO before me this 30th day of November, 19 83

Geraldine T. Rowland
 Geraldine T. Rowland Notary Public.

My Commission expires: 2-26-84

RECEIVED
 STATE CORPORATION COMMISSION

DEC 27 1983