


STATE OF KANSAS
STATE CORPORATION COMMISSION

WELL PLUGGING RECORD

Give All Information Completely
Make Required Affidavit
Mail or Deliver Report to:
Conservation Division
State Corporation Commission
212 No. Market
Wichita, Kansas

Kingman County, Sec. 31 Twp. 30S Rge. 10 (E) W (W)

Location as "NE/CNW/SW" or footage from lines C SW NE
Lease Owner Lee Phillips Oil Co.
Lease Name Mease Well No. 1
Office Address 1532 Wichita Plaza, Wichita, Kansas
Character of Well (completed as Oil, Gas or Dry Hole) Dry hole
Date well completed 11-21 19 67
Application for plugging filed 11-21 19 67
Application for plugging approved 11-21 19 67
Plugging commenced 11-21 19 67
Plugging completed 11-21 19 67
Reason for abandonment of well or producing formation Dry Hole

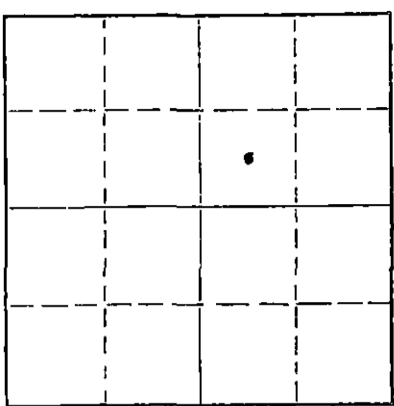

Locate well correctly on above
Section Plat

If a producing well is abandoned, date of last production 19
Was permission obtained from the Conservation Division or its agents before plugging was commenced? Yes

Name of Conservation Agent who supervised plugging of this well Archie Elving
Producing formation _____ Depth to top _____ Bottom _____ Total Depth of Well _____ Feet
Show depth and thickness of all water, oil and gas formations.

OIL, GAS OR WATER RECORDS

CASING RECORD

FORMATION	CONTENT	FROM	TO	SIZE	PUT IN	PULLED OUT
Surface Pipe		-0-	247'	8 5/8	247'	-0-

Describe in detail the manner in which the well was plugged, indicating where the mud fluid was placed and the method or methods used in introducing it into the hole. If cement or other plugs were used, state the character of same and depth placed, from _____ feet to _____ feet for each plug set.

Filled hole with heavy mud.
#1 plug @ 235' 25 sks. cement 1/2 sk. hulls
#2 plug @ 40' 10 sks. cement 1/2 sk. hulls
#3 plug in rat hole with 2 sks. cement

RECEIVED
NOV 27 1967
CONSERVATION DIVISION
WICHITA, KANSAS
11-27-67

(If additional description is necessary, use BACK of this sheet)
Name of Plugging Contractor Sweetman Drilling, Inc.
Address Box 645, Great Bend, Kansas 67530

STATE OF Kansas, COUNTY OF Barton, ss.
_____, (employee of owner) or (owner or operator) of the above-described well, being first duly sworn on oath, says: That I have knowledge of the facts, statements, and matters herein contained and the log of the above-described well as filed and that the same are true and correct. So help me God.
(Signature) T.D. Sweetman

SUBSCRIBED AND SWORN TO before me this 27 day of November 19 67
(Address)
Keata L Boyd
Notary Public.
My commission expires 5-9-71

WELL LOG
Mease #1
C SW NE 31-30S-10W
Kingman County, Kansas

Elevation: 1752' K.B.

FROM	TO	
0	40	Sand
40	815	Red bed & shale
815	1480	Shale
1480	1785	Shale & lime
1785	1865	Lime
1865	2280	Shale & lime
2280	3280	Lime & Shale
3280	3693	Shale & Lime
3693	3831	Shale & sand
3831	3877	Lime & shale
3877	4304	Lime
4304	4389	Lime & shale
4389	4523	Lime
4523	4679	Shale & lime
4679	4754	Lime
4754	4761	Sand
4761	4790	Lime
4790		Total Depth

RECEIVED
STATE CORPORATION COMMISSION
NOV 27 1967
CONSERVATION DIVISION
Topeka, Kansas

STATE OF KANSAS
COUNTY OF BARTON ss

T. D. Sweetman, Partner of Sweetman Drilling, Inc., being first duly sworn on oath says: That I have knowledge of the facts, statements and matters herein contained and the log of the above described well as filed and that the same are true and correct.

T. D. Sweetman
T. D. Sweetman

Subscribed and sworn before me this 22nd day of November, 1967.

Arthur J. Boyd
Notary Public Barton County

My Commission Expires 5-9-71