


Give All Information Completely  
Make Required Affidavit  
Mail or Deliver Report to:  
Conservation Division  
State Corporation Commission  
212 North Market, Insurance Bldg.  
Wichita, Kansas

WELL PLUGGING RECORD

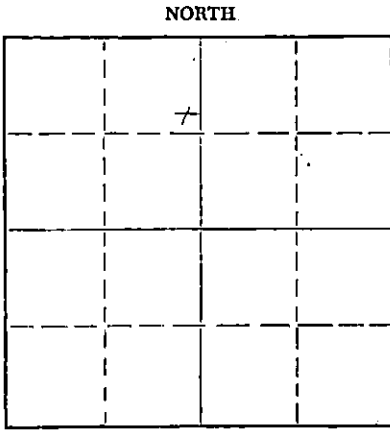

Locate well correctly on above Section Plat

Reno County, Sec. 9 Twp. 22 Rge. 8 (E) (W)  
Location as "NE/CNW/SW" or footage from lines SE NE NW  
Lease Owner Thos. H. Allan  
Lease Name Stubs Well No. 2  
Office Address 905 Union Center Bldg.  
Character of Well (completed as Oil, Gas or Dry Hole) oil  
Date well completed 19\_\_\_\_  
Application for plugging filed July 13, 1959 19\_\_\_\_  
Application for plugging approved July 13, 1959 19\_\_\_\_  
Plugging commenced July 13, 1959 19\_\_\_\_  
Plugging completed July 17, 1959 19\_\_\_\_  
Reason for abandonment of well or producing formation dry

If a producing well is abandoned, date of last production 19\_\_\_\_  
Was permission obtained from the Conservation Division or its agents before plugging was commenced? yes

Name of Conservation Agent who supervised plugging of this well Fred Hampell  
Producing formation \_\_\_\_\_ Depth to top \_\_\_\_\_ Bottom \_\_\_\_\_ Total Depth of Well 3421 Feet  
Show depth and thickness of all water, oil and gas formations.

OIL, GAS OR WATER RECORDS

CASING RECORD

FORMATION	CONTENT	FROM	TO	SIZE	PUT IN	PULLED OUT

Describe in detail the manner in which the well was plugged, indicating where the mud fluid was placed and the method or methods used in introducing it into the hole. If cement or other plugs were used, state the character of same and depth placed, from \_\_\_\_\_ feet to \_\_\_\_\_ feet for each plug set.

Sanded hole back to 3400' mixed and run 5 sacks cement  
Mud to 170' set 10' rock bridge with 20 sacks cement  
Mud to 40' set 10' rock bridge run 10 sacks cement to base of cellar.

RECEIVED  
STATE CORPORATION COMMISSION  
JUL 22 1959  
CONSERVATION DIVISION  
Wichita, Kansas

(If additional description is necessary, use BACK of this sheet)  
Name of Plugging Contractor Southwest Casing Pulling Co., Inc.  
Address Box 364, Great Bend, Kansas

STATE OF Kansas COUNTY OF Barton, ss.  
Southwest Casing Pulling Co., Inc. (employee of owner) or (owner or operator) of the above-described well, being first duly sworn on oath, says: That I have knowledge of the facts, statements, and matters herein contained and the log of the above-described well as filed and that the same are true and correct. So help me God.

(Signature) Roy L. Myers, Sec. Treas.  
Box 364, Great Bend, Kansas  
(Address)

SUBSCRIBED AND SWORN TO before me this 20 day of July, 1959

My commission expires December 18, 1959

Juanita B. Myers Notary Public.

PLUGGING  
FILE SEC 9 T 22 R 8 W  
BOOK PAGE 50 LINE 35

8 5/8" @ 182' - 135 Sx  
5 1/2" @ 3412' - 75 Sx

ALLAN, ET AL #2 STUBBS  
SE NE NW 9-22-6W  
Reno County, Kansas  
COMM: 10/3/54 COMPL: 10/20/54  
CONTRACTOR: Tom Allan  
ELEVATION: 1682 RB

I.P. 2 bbl./hr.

All Depths from Rotary Bushings

0 - 60 Soil  
 110 Sand  
 140 Yellow Clay  
 182 Red Bed  
 600 Red Rock  
 800 Shale  
 1100 Salt & Shale  
 1200 Shale  
 1300 Anhydrite  
 1400 Shale  
 1500 Lime  
 1800 Shale & Shells  
 2000 Lime & Shale  
 2550 Shale & Shells  
 2600 Lime & Shale Breaks  
 2999 Shale  
 3007 Lime, Brown  
 3027 Shale  
 3050 Lime White  
 3060 Shale  
 3080 Lime  
 3095 Shale & Shells  
 3116 Brown Lime  
 3133 Lime & Shale  
 3142 Oolitic Lime (Water)  
 3164 White Lime  
 3180 Shale & Shells  
 3210 Lime & Shale Breaks  
 3226 Lime  
 3236 Soft Lime partly Oolitic  
 3250 Lime  
 3270 Cherty Lime  
 3300 Lime & Shale Breaks  
 3320 Cherty Lime  
 3370 Lime  
 3400 Gray & Red Shale & Shells  
 3412 White Vitreous Chert  
 Ran 5 1/2" Casing to bottom  
 CHANGED TO CABLE TOOLS  
 3421 Same, small show free oil  
 3424 (T.D.) Red & Green Shale  
 Bail 3 gal. oil/hr.  
 Plugged back to 3418 1/2  
 Oil Frac 210 bbl. oil & 5000# Sand  
 Flowed 2 bbl./hr. after seed returned

FORMATIONS:

2999 Top Brown Lime  
 3027 Top Lansing  
 3400 Top Mississippi  
 3421 Top Kinderhook

RECEIVED  
 CORPORATION COMMISSION  
 JUL 13 1959  
 CONSERVATION DIVISION  
 Wichita, Kansas

PLUGGING  
 FILE SEC. 9 T22 R PW  
 BOOK PAGE 50 LINE 35