


STATE OF KANSAS
STATE CORPORATION COMMISSION

Form CP-4

Give All Information Completely
Make Required Affidavit
Mail or Deliver Report to:
Conservation Division
State Corporation Commission
P. O. Box 17027
Wichita, Kansas 67217
NORTH

WELL PLUGGING RECORD

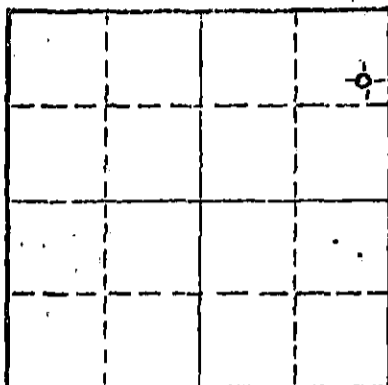

Locate well correctly on above Section Plat

Stafford County, Sec. 7 Twp. 22S Rge. 11 (E) W (W)
Location as "NE/CNWSW" or footage from lines SE NE NE
Lease Owner L. K. Parrish
Lease Name Keith Well No. 1
Office Address 714 Fourth Natl Bldg, Wichita, Ks 67202
Character of Well (completed as Oil, Gas or Dry Hole) Dry Hole
Date well completed April 20 19 74
Application for plugging filed April 20 19 74
Application for plugging approved April 20 19 74
Plugging commenced April 20 19 74
Plugging completed April 21 19 74
Reason for abandonment of well or producing formation Too low structurally

If a producing well is abandoned, date of last production 19
Was permission obtained from the Conservation Division or its agents before plugging was commenced? Yes

Name of Conservation Agent who supervised plugging of this well W. L. Nichols, Morland, Kansas
Producing formation _____ Depth to top _____ Bottom _____ Total Depth of Well 3638 Feet
Show depth and thickness of all water, oil and gas formations.

OIL, GAS OR WATER RECORDS

CASING RECORD

FORMATION	CONTENT	FROM	TO	SIZE	PUT IN	PULLED OUT
				8 5/8"	278, 35'	None

Describe in detail the manner in which the well was plugged, indicating where the mud fluid was placed and the method or methods used in introducing it into the hole. If cement or other plugs were used, state the character of same and depth placed, from _____ feet to _____ feet for each plug set.

Filled with heavy mud to 500'. Set plug. Put in 40 sacks cement. Filled with heavy mud to 250'. Set plug. Put in 30 sacks cement. Filled with heavy mud up to 40'. Set plug. Filled to top with 15 sacks cement.

RECEIVED
STATE CORPORATION COMMISSION
MAY 3 - 1974
CONSERVATION DIVISION
Wichita, Kansas

(If additional description is necessary, use BACK of this sheet)

Name of Plugging Contractor C-G DRILLING CO.
Address 1107 Union National Building, Wichita, Kansas 67202

STATE OF KANSAS, COUNTY OF SEDGWICK ss.
Jay H. Galloway (employee of owner) or (owner or operator) of the above-described

well, being first duly sworn on oath, says: That I have knowledge of the facts, statements, and matters herein contained and the log of the above-described well as filed and that the same are true and correct. So help me God.

(Signature) _____
1107 Union National Building
(Address)

Subscribed and sworn to before me this 26th day of April 19 74



December 7, 1975

Phyllis Buchanan
Notary Public.


KANSAS DRILLERS LOG

S. 7 T. 22S R. 11W^E_W

Loc. SE NE NE

County STAFFORD

640 Acres
N

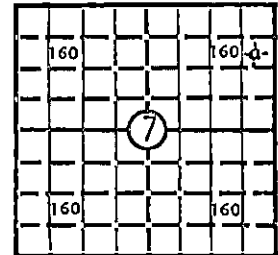

Locate well correctly

Elev.: Gr. _____

DF _____ KB 1798

API No. 15 — 185 — 20493-0000
County Number

Operator L. K. PARRISH		
Address 714 FOURTH NATIONAL BUILDING, WICHITA, KS. 67202		
Well No. 1	Lease Name KEITH	
Footage Location 660 feet from (N) (S) line 330 feet from (E) (W) line		
Principal Contractor C-G DRILLING CO.	Geologist LLOYD K PARRISH, JR.	
Spud Date April 9, 1974	Total Depth 3638	P.B.T.D.
Date Completed	Oil Purchaser	

CASING RECORD

Report of all strings set — surface, intermediate, production, etc.

Purpose of string	Size hole drilled	Size casing set (in O.D.)	Weight lbs/ft.	Setting depth	Type cement	Sacks	Type and percent additives
Surface	12 1/4"	8 5/8"	20#	278.35	60-40 Pozmix	225	2% Gel 3% C C

LINER RECORD

PERFORATION RECORD

Top, ft.	Bottom, ft.	Sacks cement	Shots per ft.	Size & type	Depth interval

TUBING RECORD

Size	Setting depth	Packer set at

ACID, FRACTURE, SHOT, CEMENT SQUEEZE RECORD

Amount and kind of material used	Depth interval treated

RECEIVED
STATE CORPORATION COMMISSION
MAY 3 - 1974
CONSERVATION DIVISION
Wichita, Kansas

INITIAL PRODUCTION

Date of first production	Producing method (flowing, pumping, gas lift, etc.)				
RATE OF PRODUCTION PER 24 HOURS	Oil bbls.	Gas bbls.	Water MCF	Gas-oil ratio	CFPB
Disposition of gas (vented, used on lease or sold)			Producing interval (s)		

INSTRUCTIONS: As provided in KCC Rule 82-2-125, within 90 days after completion of a well, one completed copy of this Drillers Log shall be transmitted to the State Geological Survey of Kansas, 4150 Monroe Street, Wichita, Kansas 67209. Copies of this form are available from the Conservation Division, State Corporation Commission, 3830 So. Meridian (P.O. Box 17027), Wichita, Kansas 66217. Phone AC 316-522-2206. If confidential custody is desired, please note Rule 82-2-125. Drillers Logs will be on open file in the Oil and Gas Division, State Geological Survey of Kansas, Lawrence, Kansas 66044.

Operator
PARRISH OIL COMPANY

DESIGNATE TYPE OF COMP.: OIL, GAS,
 DRY HOLE, SWDW, ETC.:
DRY HOLE

Well No. **1** Lease Name **KEITH**

S 7 T 22S R 11W E
W

WELL LOG

Show all important zones of porosity and contents thereof; cored intervals, and all drill-stem tests, including depth interval tested, cushion used, time tool open, flowing and shut-in pressures, and recoveries.

SHOW GEOLOGICAL MARKERS, LOGS RUN, OR OTHER DESCRIPTIVE INFORMATION.

FORMATION DESCRIPTION, CONTENTS, ETC.	TOP	BOTTOM	NAME	DEPTH
RED BED	0	590		
SAND	590	790		
SHALE	790	1380		
LIME & SHALE	1380	3265		
LIME	3265	3603		
ARBUCKLE	3603	3613		
LIME	3613	3638		
TD		3638		
DST #1 3355-3394 Open 20 SI 60 Open 60 SI 90 Rec 250' gas 15' VHOCM, 175' muddy water IFP 56# FFP 112# IBHP 1069# FBHP 980#				
DST #2 3594-3603' Open 20 SI 60 Open 60 SI 90 Rec 20' mud IFP 32# FFP 32# IBHP 860# FBHP 732#				
DST #3 3603-3613' Open 30 SI 25 Rec 51' Mud IFP 43# FFP 43# FBHP 711#				
DST #4 2304-2454 Open 10 SI 90 Rec 540' mud IFP 240# FFP 240# FBHP 998#				
DST #5 3618-3638' Open 20 SI 60 Open 60 SI 90 Rec 60' SI OC gassy mud, 300' GC muddy water IFP 65# FFP 184#, IBHP 817#, FBHP 647#				

RECEIVED
 STATE CORPORATION COMMISSION
 DIVISION OF OIL AND GAS
 MAY 3 1974
 CONSERVATION DIVISION

USE ADDITIONAL SHEETS, IF NECESSARY, TO COMPLETE WELL RECORD.

Date Received

Phyllis Buchanan
 Signature Phyllis Buchanan
 Office Manager
 Title
 April 26, 1974
 Date