

WELL PLUGGING RECORD

STATE OF KANSAS CORPORATION COMMISSION
Information Completely Make Required Affidavit
Mail or Deliver Report to: Conservation Division
State Corporation Commission
211 No. Broadway
Wichita, Kansas

305

Kingman County, Sec. 23 Twp. 23S Rge. 10W (XXXXXXX)

Location as "NE/CNW/SW" or footage from lines C SW SE
Lease Owner Mallonee-Mahoney, Inc.

Lease Name Shaulfer Well No. 1
Office Address 925 Sutton Place, 209 East William, Wichita, Kansas

Character of Well (completed as Oil, Gas or Dry Hole) Dry Hole

Date well completed September 9, 1974

Application for plugging filed September 9, 1974

Application for plugging approved September 9, 1974


Plugging commenced 4:30 P.M. September 9, 1974

Plugging completed: 8:00 P.M. September 9, 1974

Reason for abandonment of well or producing formation nonproduction

If a producing well is abandoned, date of last production 19

Was permission obtained from the Conservation Division or its agents before plugging was commenced? Yes

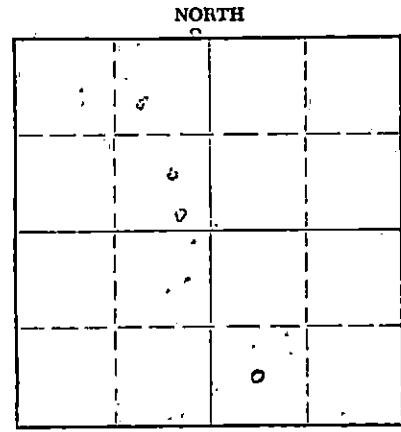

Locate well correctly on above Section Plat

Name of Conservation Agent who supervised plugging of this well Russell Biberstein
Producing formation None Depth to top Bottom Total Depth of Well 4672 Feet

Show depth and thickness of all water, oil and gas formations.

OIL, GAS OR WATER RECORDS

CASING RECORD

Table with 7 columns: FORMATION, CONTENT, FROM, TO, SIZE, PUT IN, PULLED OUT. Row 1: Surface, 249', 8 5/8", 241.44'

Describe in detail the manner in which the well was plugged, indicating where the mud fluid was placed and the method or methods used in introducing it into the hole. If cement or other plugs were used, state the character of same and depth placed, from feet to feet for each plug set.

35 sacks @ 240'

15 sacks @ 40'

2 sacks in rat hole

Pumped by Halliburton Company

RECEIVED STATE CORPORATION COMMISSION SEP 30 1974 CONSERVATION DIVISION Wichita, Kansas


(If additional description is necessary, use BACK of this sheet)

Name of Plugging Contractor Gabbert-Jones, Inc.
Address 830 Sutton Place, Wichita, Kansas 67202

STATE OF Kansas, COUNTY OF Sedgwick, ss.
F. W. Mallonee (employee of owner or owner or operator) of the above-described well, being first duly sworn on oath, says: That I have knowledge of the facts, statements, and matters herein contained and the log of the above-described well as filed and that the same are true and correct. So help me God.

(Signature) F. W. Mallonee
925 Sutton Place, 209 E. William, Wichita, Ks.
(Address) 67202

Subscribed and sworn to before me this 26th day of September, 1974

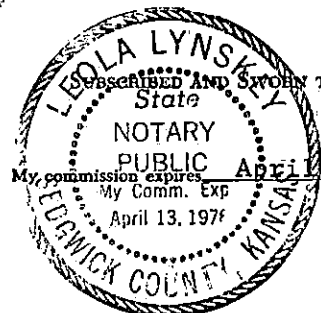

Leola Lynskey
Notary Public.

GABBERT-JONES, INC.
WICHITA, KANSAS
DRILLERS' WELL LOG

Schaufler #1
C-SW-SE Sec 23-30S-10W
Kingman County Kansas

Commenced: 8-28-74

Completed: 9-9-74

OPERATOR: MALLONEE-MAHONEY

Depth		Formation	Remarks
From	to		
0	145	Sand	
145	925	Red Rock-Shale	Ran 6 jts of New 8 5/8" csg @ 249' Cemented
925	1880	Shale-Shells	w/250 sks Common 3% CC
1880	2015	Shale-Lime	P.D. @ 8:00 P.M. 8-28-74
2015	2838	Lime-Shale	Cement circ
2838	3145	Shale-Lime	
3145	3290	Lime	
3290	3640	Lime-Shale	
3640	3756	Shale-Sand	
3756	3810	Lime-Shale	
3810	4435	Lime	
4435	4515	Shale-Lime	
4515	4615	Shale	
4615	4670	Lime	
4670	4673	Sand	
	4673 TD		DRY & ABANDONED

RECEIVED
STATE CORPORATION COMMISSION
SEP 30 1974
CONSERVATION DIVISION
Wichita, Kansas

I, James S. Sutton II, certify this is a correct copy of the Drillers' Log for the well drilled C-SW-SE Sec 23-30S-10W, Kingman County Kansas to the best of my knowledge and belief.

James S. Sutton II
JAMES S. SUTTON II

STATE OF KANSAS)
) SS
COUNTY OF SEDGWICK)

Before me, the undersigned, a Notary Public withing and for said County and State, on this 24th day of September, 1974, personally appeared James S. Sutton II to me personally known to be the identical person who executed the within and foregoing instrument and acknowledged to me that he executed the same as his free and voluntary act and deed for the uses and purposes therein set forth.

IN WITNESS WHEREOF, I have hereunto set my hand and official seal the day and year last above written.

Marjorie Hall
MARJORIE HALL-NOTARY PUBLIC

My Commission Expires: November 29th, 1975.

