


STATE OF KANSAS
STATE CORPORATION COMMISSION

Form CP-4

Give All Information Completely
Make Required Affidavit
Mail or Deliver Report to:
Conservation Division
State Corporation Commission
212 No. Market
Wichita, Kansas

WELL PLUGGING RECORD

NORTH

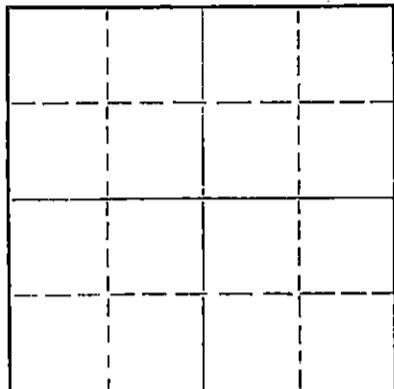

Locate well correctly on above
Section Plat

Kingman County. Sec. 27 Twp. 30S. Rge. (E) 10(W)
Location as "NE/CNW/SW" or footage from lines C E/2 SE/4
Lease Owner Clinton Oil
Lease Name W. Hudson Well No. 1-V
Office Address 217 N. Water, Wichita, Kansas 67202
Character of Well (completed as Oil, Gas or Dry Hole) Dry Hole
Date well completed July 13, 19 72
Application for plugging filed 19
Application for plugging approved 19
Plugging commenced July 13, 19 72
Plugging completed July 13, 19 72
Reason for abandonment of well or producing formation Dry Hole

If a producing well is abandoned, date of last production 19
Was permission obtained from the Conservation Division or its agents before plugging was commenced? Yes (Russell Biberstein)

Name of Conservation Agent who supervised plugging of this well
Producing formation Depth to top Bottom Total Depth of Well Feet
Show depth and thickness of all water, oil and gas formations.

OIL, GAS OR WATER RECORDS

CASING RECORD

FORMATION	CONTENT	FROM	TO	SIZE	PUT IN	PULLED OUT
	Surface	0	250'			
	Casing					

Describe in detail the manner in which the well was plugged, indicating where the mud fluid was placed and the method or methods used in introducing it into the hole. If cement or other plugs were used, state the character of same and depth placed, from feet to feet for each plug set.

Heavy Mud from Total Depth to 225 Feet,
1/2 sax Hulls, Plug and 25 sax Cement;
Mud to 40 Feet, 1/2 sax Hulls, Plug Bridged
and 10 sax Cement to Base of Cellar;
2 sax cement in Rat Hole. Job Completed
@ 2:00 P.M.

RECEIVED
STATE CORPORATION COMMISSION
JUL 21 1972
CONSERVATION DIVISION
Wichita, Kansas
7-21-72

(If additional description is necessary, use BACK of this sheet)

Name of Plugging Contractor Sage Drilling Company, Inc.
Address 500 Bitting Building, Wichita, Kansas 67202

STATE OF KANSAS, COUNTY OF SEDGWICK, ss.
Clarence Michael of Sage Drilling Co (employee of owner) or (owner or operator) of the above-described well, being first duly sworn on oath, says: That I have knowledge of the facts, statements, and matters herein contained and the log of the above-described well as filed and that the same are true and correct. So help me God.

(Signature) Clarence Michael
500 Bitting Building, Wichita, Kansas
(Address)

19th day of July 19 72
Marilyn M. Theissen
Notary Public.



6-25

COPY

15-095-20282-0000

DRILLERS LOG

W. HUDSON NO. 1-V

CASING RECORD:	OPERATOR:	Clinton Oil	DESCRIPTION:
8-5/8" @ 250'	Contractor:	Sage Drilling Co.	C E/2 SE/4
w/200 sax cement	COMMENCED:	July 8, 1972	Sec. 27-30S-10W
TOTAL DEPTH:	COMPLETED:	July 13, 1972	Kingman Co., Kansas
3160'			ELEVATION: 1697 GL

<u>FORMATION</u>	<u>FROM</u>	<u>TO</u>	<u>REMARKS</u>
Clay	0	30	
Sand	30	130	
Red Bed	130	253	
Shale	253	342	
Red Bed and Shale	342	1060	
Shale	1060	1730	
Lime and Shale	1730	1950	
Lime and Shale	1950	2190	
Lime and Shale	2190	2256	
Lime and Shale	2256	2360	
Lime and Shale	2360	2586	
Sand, Lime and Shale	2586	2800	
Lime and Shale	2800	2855	
Lime and Shale	2855	3075	
Lime and Shale	3075	3160	

RECEIVED
STATE CORPORATION COMMISSION
AUG 24 1972
CONSERVATION DIVISION
Wichita, Kansas

D&A

I certify that this is a true and correct copy of the above log to the best of my knowledge.

SAGE DRILLING CO., INC.

BY Clarence Michael
CLARENCE MICHAEL

Subscribed and sworn to before me this 19th day of July, 1972.

My Comm Expires 6-6-75 Margie M. DeLander
Notary Public

