


WELL PLUGGING RECORD

Give All Information Completely
Make Required Affidavit
Mail or Deliver Report to:
Conservation Division
State Corporation Commission
211 No. Broadway
Wichita, Kansas

Kingman County. Sec. 29 Twp. 30 Rge. 10 W-(E)---(W)
Location as "NE/CNW%SW%" or footage from lines C NW NW
Lease Owner Duncan Operating Company
Lease Name Oak Well No. 1
Office Address 401 4th National Building, Wichita, Ks.
Character of Well (completed as Oil, Gas or Dry Hole) Dry Hole
Date well completed June 3 1960
Application for plugging filed June 3 1960
Application for plugging approved June 3 1960
Plugging commenced June 3 1960
Plugging completed June 3 1960
Reason for abandonment of well or producing formation no oil and/or gas found
in commercial quantities
If a producing well is abandoned, date of last production 19
Was permission obtained from the Conservation Division or its agents before plugging was commenced? yes

NORTH

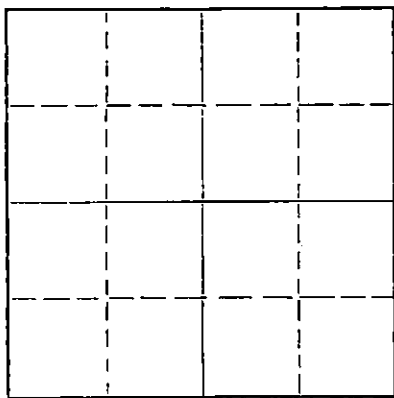

Locate well correctly on above
Section Plat

Name of Conservation Agent who supervised plugging of this well Donald Truan,
Producing formation _____ Depth to top _____ Bottom _____ Total Depth of Well 4793' Feet
Show depth and thickness of all water, oil and gas formations.

OIL, GAS OR WATER RECORDS

CASING RECORD

FORMATION	CONTENT	FROM	TO	SIZE	DEPTH	PULLED OUT
				8-5/8" set at 294.15'		none

Describe in detail the manner in which the well was plugged, indicating where the mud fluid was placed and the method or methods used in introducing it into the hole. If cement or other plugs were used, state the character of same and depth placed, from _____ feet to _____ feet for each plug set.

Filled hole with extra heavy rotary mud from total depth to 290'. Bridge plug and 1/4 sx. Hulls & 25 sacks cement. Filled hole with extra heavy rotary mud to 35', bridge plug & 1/2 sx. of Hulls and 10 sacks cement to bottom of cellar. Plugged Rathole.

RECEIVED
STATE CORPORATION COMMISSION

JUN 7 1960 6-7-60

CONSERVATION DIVISION
Wichita, Kansas

(If additional description is necessary, use BACK of this sheet)


Name of Plugging Contractor Capitt Drilling, Inc.
Address 814 Union Center, Wichita, Kansas

STATE OF KANSAS, COUNTY OF Sedgwick, ss.
R. R. McNicol (employee of owner) or (owner or operator) of the above-described well, being first duly sworn on oath, says: That I have knowledge of the facts, statements, and matters herein contained and the log of the above-described well as filed and that the same are true and correct. So help me God.

(Signature) R. R. McNicol
814 Union Center, Wichita, Kansas
(Address)

Subscribed and sworn to before me this 6th day of June, 1960

Darlene May
Darlene May Notary Public.
My commission expires Sept. 30, 1963

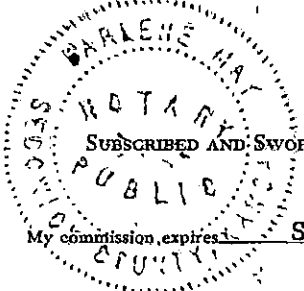

ROTARY DRILLING LOG

OPERATOR: Duncan Operating Company
OAK NO. 1
C NW NW Sec. 29-30S-10W,
Kingman County, Kansas

CONTRACTOR: Capitt Drilling, Inc.
COMM: 5-17-60
COMP: 6-3-60

Remarks: Set 8-5/8" surface
casing at 294.15'
cemented with 225 sacks cement.

Formations:

Sand	120'
Shale	290'
Shale & Lime	296'
Shale & Shells	710'
Shale & Sand	880'
Shale & Shells	1215'
Shale & Lime	1645'
Lime	2060'
Lime w/Shale Breaks	2200'
Lime & Shale	2230'
Shale	2325'
Lime & Shale	2505'
Lime w/Shale Breaks	2653'
Shale w/Lime Streaks	2875'
Shale & Lime	2930'
Lime	3010'
Lime w/Shale Breaks	3115'
Lime & Shale	3210'
Lime	3545'
Lime & Shale	3630'
Lime	3795'
Sand & Shale	3842'
Lime	4320'
Lime & Shale	4447'
Lime	4452'
Lime & Chert	4483'
Shale & Lime	4678'
Lime & Chert	4703'
Lime	4754'
Sand & Shale	4788'
Sand	4793'
Rotary Total Depth (D&A)	4793'

RECEIVED
STATE CORPORATION COMMISSION

JUN 7 1960

CONSERVATION DIVISION
Wichita, Kansas

We certify the above log is true and
correct to the best of our knowledge
and belief.

CAPITT DRILLING, INC.

R.R. McNicol

R. R. McNicol