


STATE OF KANSAS
STATE CORPORATION COMMISSION

WELL PLUGGING RECORD

Give All Information Completely
Make Required Affidavit
Mail or Deliver Report to
Conservation Division
State Corporation Comm.
245 North Water
Wichita, KS 67202

Russell County, Sec. 2 Twp. 14 Rge. 15 ~~X~~/W
Location as "NE/CNW $\frac{1}{4}$ SW $\frac{1}{4}$ " or footage from lines
W/2 SE/4 SE/4 NW/4

Lease Owner Richard L. Mai
Lease Name Roubach Well No. 14
Office Address Russell, Kansas 67665
Character of Well (Completed as Oil, Gas or Dry Hole)

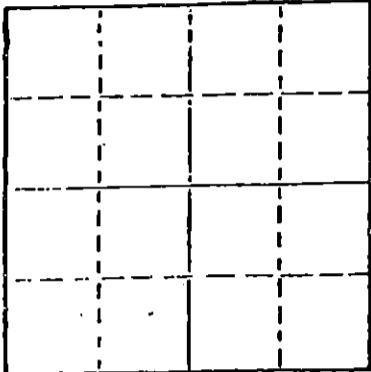

Locate well correctly on above
Section Plat

Dry Hole
Date Well completed 11-25 19 78
Application for plugging filed " 19
Application for plugging approved " 19
Plugging commenced " 19
Plugging completed " 19
Reason for abandonment of well or producing formation

Dry Hole
If a producing well is abandoned, date of last production 19

Was permission obtained from the Conservation Division or
its agents before plugging was commenced? Yes

Name of Conservation Agent who supervised plugging of this well Don Truan
Producing formation Depth to top Bottom Total Depth of Well 904
Show depth and thickness of all water, oil and gas formations. 940

OIL, GAS OR WATER RECORDS

CASING RECORD

FORMATION	CONTENT	FROM	TO	SIZE	PUT IN	PULLED OUT
				8 5/8	804'	Cmtd w/450 sax

Describe in detail the manner in which the well was plugged, indicating where the mud fluid was placed and the method or methods used in introducing it into the hold. If cement or other plugs were used, state the character of same and depth placed, from feet to feet for each plug set.

Push bridge plug to 745'
Spotted 125 sax cement on plug thru 4 1/2" drill pipe
Push bridge plug to 40' w/1/2 sax hulls on plug
Dump 10 sax cement on plug to cellar

(If additional description is necessary, use BACK of this sheet)

Name of Plugging Contractor Shields Drilling Co., Inc. Shields Bldg., Russell, Kansas 67665

STATE OF Kansas COUNTY OF Russell, ss. Contractor
R. L. Shields (employee of owner) or (owner or operator)
of the above-described well, being first duly sworn on oath, says: That I have knowledge of the facts, statements, and matters herein contained and the log of the above-described well as filed and that the same are true and correct. So help me God.

(Signature) R. L. Shields
Shields Bldg., Russell, Kansas 67665
(Address)

SUBSCRIBED AND SWORN TO before me this 15th day of December, 19 78

Ruth Phillips
Notary Public.

My commission expires May 26, 1979

RECEIVED
STATE CORPORATION COMMISSION
DEC 18 1978
CONSERVATION DIVISION
Wichita, Kansas
12-18-78



Shields


WELL LOG

15-167.21261-0000

Russell, Kansas

Operator: Richard L. Mai
 Well: Roubach #14
 Commenced: November 21, 1978
 Completed: November 25, 1978
 Contractor: Shields Drilling Co., Inc.

Well Description: W/2 SE/4 SE/4 NW/4
 Sec. 2-14S-15W
 Russell Co., Kansas

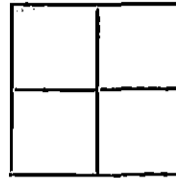

CASING RECORD		
Size	Run	Pulled
8 5/8"	804'	Cmtd w/450 sax

Elevation:
 Treatment:
 Production: D & A
 Tops:

..... Figures Indicate Bottom of Formations

Surface soil, clay & sand	80'
Shale & sand	465'
Shale	588'
Sand	614'
Redbed	937'
Anhydrite	940' RTD

RECEIVED
 STATE CORPORATION COMMISSION

DEC 18 1978

CONSERVATION DIVISION
 Wichita, Kansas

Notes