

NOTICE OF INTENTION TO DRILL

(see rules on reverse side)

Starting Date April 22, 1987
month day year

API Number 15— 095-21568-0000

OPERATOR: License # 7105
Name Spines Exploration, Inc
Address 525 Fourth Financial Center
City/State/Zip Wichita, Ks. 67202
Contact Person Robert Spurlock
Phone 264-2808

_____ East
c. SW. SW. Sec 29 Twp. 30 S, Rg. 10 X West
660
4620
Ft. from South Line of Section
Ft. from East Line of Section

(Note: Locate well on Section Plat on reverse side)

CONTRACTOR: License # 5380
Name Eagle Drilling Co
City/State Wichita, Ks

Nearest lease or unit boundary line .. 660 feet
County Kingman

Well Drilled For: Well Class: Type Equipment:
X Oil SWD Infield X Mud Rotary
Gas Inj Pool Ext Air Rotary
OWWO Expl Wildcat Cable

Lease Name Hellman Well # 1
Ground surface elevation feet MSL

If OWWO: old well info as follows:

Domestic well within 330 feet: yes no
Municipal well within one mile: yes X no
Surface pipe by Alternate: 1 X 2

Operator
Well Name
Comp Date Old Total Depth

Depth to bottom of fresh water... 200 ft
Depth to bottom of usable water . 200 ft
Surface pipe planned to be set 250 ft
Projected Total Depth 4900 ft feet
Formation Simpson

I certify that well will comply with K.S.A. 55-101, et seq., plus eventually plugging hole to KCC specifications.

cementing will be done immediately upon setting production casing.

Date April 15, 1987 Signature of Operator or Agent Robert Spurlock Title Operations Manager

For KCC Use:

Conductor Pipe Required feet; Minimum Surface Pipe Required 200 feet per Alt. OPR


This Authorization Expires 12-16-87 Approved By 4-16-87

Must be filed with the K.C.C. five (5) days prior to commencing well
This card void if drilling not started within six (6) months of date received by K.C.C.

Important procedures to follow:

1. Notify District office before setting surface casing.
2. Set surface casing by circulating cement to the top.
3. File completion forms ACO-1 with K.C.C. within 90 days of well completion, following instructions on ACO-1, side 1, and including copies of wireline logs.
4. Notify District office 48 hours prior to old well workover or re-entry.
5. Prior to filing Intent, prepare a proposed plugging plan in case well is D & A, then obtain approval of plan when calling district office prior to setting surface pipe.
6. Submit plugging report (CP-4) to K.C.C. after plugging is completed.
7. Obtain an approved injection docket number before disposing of salt water.
8. Notify K.C.C. within 10 days when injection commences or terminates.
9. If an alternate 2 completion, cement in the production pipe from below any usable water to surface within 120 days of spud date.

A Regular Section of Land
1 Mile = 5,280 Ft.

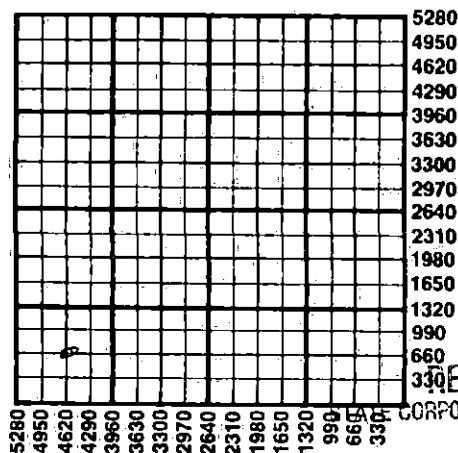

RECEIVED
CORPORATION COMMISSION

APR 15 1987

CONSERVATION DIVISION
Wichita, Kansas

4-15-87

State Corporation Commission of Kansas
Conservation Division
200 Colorado Derby Building
Wichita, Kansas 67202
(316) 263-3238