


STATE OF KANSAS
STATE CORPORATION COMMISSION
200 Colorado Derby Bldg.
Wichita, Kansas 67202

Form CP-4
Rev. 12-15-80

WELL PLUGGING RECORD

Give All Information Completely
Make Required Affidavit

COUNTY Pawnee SEC. 11 TWP. 22 RGE. 15 E/W
Location as in quarters or footage from lines:
C N/2 N/2 NE

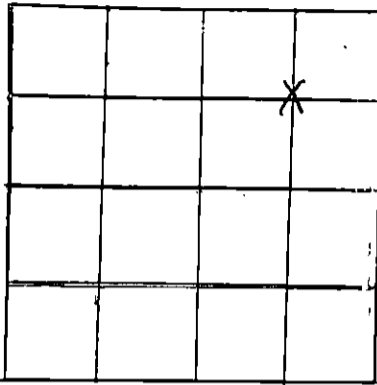

Locate Well
correctly on above
Section Platt.

Lease Owner Great Bend Oil Producers
Lease Name Crane Well No. 1
Office Address P. O. Box 1054, Great Bend, Kansas 67530
Character of Well (Completed as Oil, Gas or Dry Hole): Dry Hole
Date Well Completed 4-28-83
Application for plugging filed 4-28-83
Plugging commenced 4-28-83
Plugging completed 4-28-83
Reason for abandonment of well or producing formation Dry Hole

Was permission obtained from the Conservation Division or it's
Agent's before plugging was commenced? Yes

Name of Conservation Agent who supervised plugging of this well Bob Tarbutton
Producing formation _____ Depth to top _____ bottom _____ T.D. 3951'

Show depth and thickness of all water, oil and gas formations.

OIL, GAS OR WATER RECORDS

Casing Record

Formation	Content	From	To	Size	Put in	Pulled Out
		0	932'	8-5/8"	932'	None

Describe in detail the manner in which the well was plugged, indicating where the mud
fluid was placed and the method or methods used in introducing it into the hold. If cement
or other plugs were used, state the character of same and depth placed; from _____ feet
to _____ feet for each plug set. 105 sks 50/50 POZ, 4% Gel, 3% CC:
40 sks @ 930'
40 sks @ 420'
10 sks @ 40'
15 sks in rathole
by Allied Cementing
completed 4-28-83, 11:45 a.m.

(If additional description is necessary, use BACK of this sheet)

Name of Plugging Contractor Allen Drilling Company
P. O. Box 1389, Great Bend, Kansas 67530

STATE OF KANSAS COUNTY OF BARTON, ss.
Dale L. Smith (employee of owner) or (owner-or-operator) of the
above-described well, being first duly sworn on oath, says: That I have knowledge of the
facts, statements, and matters herein contained and the log of the above-described well as
filed and that the same are true and correct. So help me God.

(Signature) Dale L. Smith
P. O. Box 1389, Great Bend, KS 67530
(Address)

SUBSCRIBED AND SWORN TO before me this 2nd day of May, 1983

My Commission expires: _____



RECEIVED
Notary Public.
STATE CORPORATION COMMISSION

MAY 09 1983

CONSERVATION DIVISION
Wichita, Kansas