

STATE OF KANSAS
STATE CORPORATION COMMISSION

WELL PLUGGING RECORD

Give All Information Completely
Make Required Affidavit
Mail or Deliver Report to
Conservation Division
State Corporation Comm.
245 North Water
Wichita, KS 67202

Pawnee County, Sec. 11 Twp. 22S Rge. 15W E/W
Location as "NE/CNW $\frac{1}{4}$ SW $\frac{1}{4}$ " or footage from lines
NE NW SE

Lease Owner Abercrombie Drilling, Inc.

Lease Name WESLEY Well No. 1

Office Address 801 Union Center, Wichita, Kansas 67202

Character of Well (Completed as Oil, Gas or Dry Hole)
Dry Hole

Date Well completed 3-16-1977

Application for plugging filed (Verbally) 3-16-1977

Application for plugging approved (Verbally) 3-16-1977

Plugging commenced 3-16-1977

Plugging completed 3-16-1977

Reason for abandonment of well or producing formation

No commercial quantity of oil or gas encountered


If a producing well is abandoned, date of last production
19

Was permission obtained from the Conservation Division or
its agents before plugging was commenced? Yes

Name of Conservation Agent who supervised plugging of this well Maurice Towns

Producing formation Depth to top Bottom Total Depth of Well

Show depth and thickness of all water, oil and gas formations.

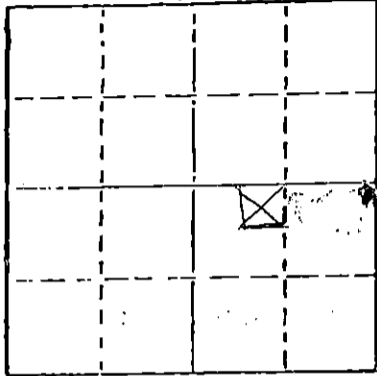

Locate well correctly on above
Section Plot

OIL, GAS OR WATER RECORDS

CASING RECORD

FORMATION	CONTENT	FROM	TO	SIZE	PUT IN	PULLED OUT

Describe in detail the manner in which the well was plugged, indicating where the mud fluid was placed and the method or methods used in introducing it into the hold. If cement or other plugs were used, state the character of same and depth placed, from feet to feet for each plug set.

T.D. 3970'
Set 1st plug at 420' with 50 sx.
2nd plug at 250' with 25 sx.
40' solid bridge with 10 sx.

APR 06 1977 4-6-77

Cemented with common cement, 2% gel,
Plug was down at 5:00 p.m. 3-16-77.
State Plugger - Leo Massey

(If additional description is necessary, use BACK of this sheet)

Name of Plugging Contractor Abercrombie Drilling, Inc.

STATE OF Kansas COUNTY OF Sedgwick ss.

Jack L. Partridge, Asst. Sec.-Treas. (employee of owner) or (owner or operator) of the above-described

well, being first duly sworn on oath, says: That I have knowledge of the facts, statements, and matters herein contained and the log of the above-described well as filed and that the same are true and correct. So help me God.

(Signature) *Jack L. Partridge*

801 Union Center, Wichita, Kansas 67202

(Address)

Subscribed and sworn to before me this 29th day of March 1977

Kathy S. Goertz
Kathy S. Goertz Notary Public.

My commission expires




KANSAS DRILLERS LOG

S. 11 T. 22S R. 15W E
W

Loc. NE NW SE

County Pawnee County, Ks.

640 Acres
N

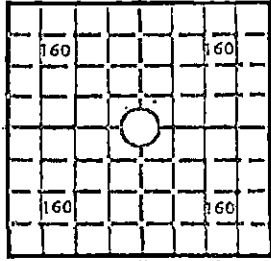

Locate well correctly
Elev.: Gr. 1967'

DF 1973' KB 1975'

API No. 15 — 145 — 20445-0000
County Number

Operator Abercrombie Drilling, Inc.

Address 801 Union Center, Wichita, Kansas 67202

Well No. 1 Lease Name WESLEY

Footage Location
feet from (N) (S) line feet from (E) (W) line

Principal Contractor Abercrombie Drilling, Inc. Geologist Robert B. Jinkins

Spud Date 3-07-77 Total Depth 3970' P.B.T.D.

Date Completed 3-16-77 Oil Purchaser

CASING RECORD

Report of all strings set—surface, intermediate, production, etc.

Purpose of string	Size hole drilled	Size casing set (in O.D.)	Weight lbs/ft.	Setting depth	Type cement	Sacks	Type and percent additives
Surface	12 1/4"	8 5/8"		329.54'	Sunset Common	250	2% gel.

LINER RECORD

PERFORATION RECORD

Top, ft.	Bottom, ft.	Sacks cement	Shots per ft.	Size & type	Depth interval

TUBING RECORD

Size	Setting depth	Packer set at

ACID, FRACTURE, SHOT, CEMENT SQUEEZE RECORD

Amount and kind of material used	Depth interval treated

INITIAL PRODUCTION

Date of first production		Producing method (flowing, pumping, gas lift, etc.)			
RATE OF PRODUCTION PER 24 HOURS	Oil	Gas	Water	Gas-oil ratio	
	bbls.	MCF	bbls.	CFPB	
Disposition of gas (vented, used on lease or sold)			Producing interval (s)		

INSTRUCTIONS: As provided in KCC Rule 82-2-125, within 90 days after completion of a well, one completed copy of this Drillers Log shall be transmitted to the State Geological Survey of Kansas, 4150 Monroe Street, Wichita, Kansas 67209. Copies of this form are available from the Conservation Division, State Corporation Commission, 3830 So. Meridian (P.O. Box 17027), Wichita, Kansas 66217. (Phone: AC 316-522-2206. If confidential custody is desired, please note Rule 82-2-125. Drillers Logs will be on an open file in the Oil and Gas Division, State Geological Survey of Kansas, Lawrence, Kansas 66044.

DESIGNATE TYPE OF COMP.: OIL, GAS, DRY HOLE, SWDW, ETC.:

Operator

Well No. 1

Lease Name

WESLEY

Dry Hole

S 11 T 22S R 15WE W

WELL LOG

Show all important zones of porosity and contents thereof; cored intervals, and all drill-stem tests, including depth interval tested, cushion used, time tool open, flowing and shut-in pressures, and recoveries.

SHOW GEOLOGICAL MARKERS, LOGS RUN, OR OTHER DESCRIPTIVE INFORMATION.

FORMATION DESCRIPTION, CONTENTS, ETC.	TOP	BOTTOM	NAME	DEPTH	
Surface Clay & Sand	0	120	<u>SAMPLE TOPS:</u> Anhydrite B/Anhydrite Heebner Toronto Douglas Brown Line Lansing Simp. Shale Arbuckle RTD		
Shale	120	1779			
Anhydrite	1778	1814		931' (+1044)	
Shale	1814	1857		953' (+1022)	
Shale & Lime	1857	2830		3386' (-1411)	
Lime & Shale	2830	3080		3404' (-1422)	
Shale & Lime	3080	3430		3419' (-1444)	
Lime & Shale	3430	3497		3497' (-1522)	
Lime	3497	3550		3507' (-1532)	
Lime & Shale	3550	3617		3898' (-1923)	
Lime	3617	3970		3964' (-1989)	
Rotary Total Depth	3970				
DST #1 (3620-3650') Covings in hole. Did not get to bottom.					
DST #2 (3620-3650') 30", 45", 30", 45". Slid 20' to bottom - tool plugged throughout. Rec. 65' mud. IBHP 1222, FBHP 1182. Conditioning hole for rerun.					
DST #3 (3618-3650') 30", 45", 30", 45". Weak blow for 50". Rec. 10' mud w/spots oil. IFP 20-20, IBHP 408, FFP 20-20, FBHP 51. Temp. 107°.					
DST #4 (3897-3970') 30", 45", 60", 60". Strong blow throughout. Rec. 2800' SW. IFP 234-816, ISIP 1313, FFP 846-1222, FSIP 1303. Temp. 110°.					

USE ADDITIONAL SHEETS, IF NECESSARY, TO COMPLETE WELL RECORD.

Date Received

Jack L. Partridge

Jack L. Partridge Signature

Assistant Secretary-Treasurer

Title

March 29, 1977

Date