


STATE OF KANSAS  
STATE CORPORATION COMMISSION

WELL PLUGGING RECORD

Give All Information Completely  
Make Required Affidavit  
Mail or Deliver Report to  
Conservation Division  
State Corporation Comm.  
245 North Water  
Wichita, KS 67202

Stafford County. Sec. 34 Twp. 22S Rge. 14W E/W  
Location as "NE/CNW $\frac{1}{4}$ SW $\frac{1}{4}$ " or footage from lines  
SW NW NE

Lease Owner Carstan Petroleum Services  
Lease Name Sizemore Well No. 1  
Office Address 8600 W. 63rd, Suite 305, Shawnee Mission, Ks.  
Character of Well (Completed as Oil, Gas or Dry Hole) 66202  
Dry Hole

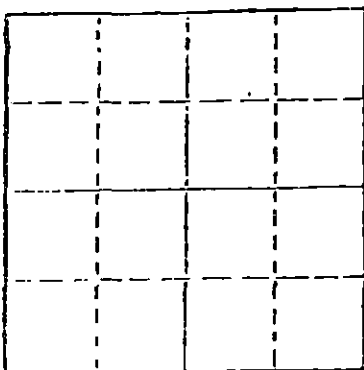

Locate well correctly on above  
Section Plot

Date Well completed 4/23/81 19  
Application for plugging filed 4/23/81 19  
Application for plugging approved 4/23/81 19  
Plugging commenced 4/23/81 19  
Plugging completed 4/23/81 19  
Reason for abandonment of well or producing formation  
Dry Hole

If a producing well is abandoned, date of last production  
19

Was permission obtained from the Conservation Division or  
its agents before plugging was commenced? yes

Name of Conservation Agent who supervised plugging of this well Maurice V. Leslie  
Producing formation \_\_\_\_\_ Depth to top \_\_\_\_\_ Bottom \_\_\_\_\_ Total Depth of Well 3657  
Show depth and thickness of all water, oil and gas formations.

OIL, GAS OR WATER RECORDS

CASING RECORD

FORMATION	CONTENT	FROM	TO	SIZE	PUT IN	PULLED OUT
	Surface	0	225'	8 5/8"	225'	None

Describe in detail the manner in which the well was plugged, indicating where the mud fluid  
was placed and the method or methods used in introducing it into the hold. If cement or other  
plugs were used, state the character of same and depth placed, from \_\_\_\_\_ feet to  
\_\_\_\_\_ feet for each plug set.

1st plug @ 520' w/60 sx  
2nd plug @ 225' w/40 sx  
3rd plug @ 40' w/10 sx  
50-50 poz, 3% gel,

5-20-81

RECEIVED

STATE CORPORATION COMMISSION

(If additional description is necessary, use BACK of this sheet)  
Name of Plugging Contractor Thunderbird Drilling, Inc.

MAY 20 1981

STATE OF KANSAS COUNTY OF SEDGWICK CONSERVATION DIVISION  
Burke Krueger (employee of owner) or Wichita, Kansas (owner or operator)

of the above-described well, being first duly sworn on oath, says: That I have knowledge of  
the facts, statements, and matters herein contained and the log of the above-described well  
as filed and that the same are true and correct. So help me God.


(Signature) Burke Krueger

P.O. Box 18407- Wichita, Ks. 67218  
(Address)

SUBSCRIBED AND SWORN TO before me this 15th day of May, 1981.

Gloria DeJesus  
Gloria DeJesus Notary Public.

My commission expires 3-25-84

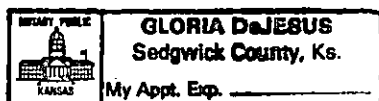

DRILLERS LOG

Company Carstan Petroleum Services  
8600 W. 63rd, Suite 305  
Shawnee Mission, Kansas 66202

Contractor Thunderbird Drilling, Inc

Elevation 1950' K.B.

Farm Sizemore

Well No. 1

Casing 8 5/8" @ 225' w/225 sx

Location SW NW NE, Sec. 34-22S-14W

County Stafford County, Ks.

Production None

<u>From</u>	<u>To</u>	<u>Description</u>
0	225	Surface hole
225	420	Sand & Shale
420	470	Redbed
470	853	Sand & Shale
853	876	Anhydrite
876	921	Shale & Sand
921	1470	Sand, Shale & Shells
1470	2166	Shale, Shells & Strks. of lime
2166	2468	Shale, Shells & Sand Strks.
2468	2760	Shale & Lime
2760	2840	Shale & Lime Strks.
2840	2940	Lime & Shale strks.
2940	3499	Shale & Lime
3499	3510	Lime
3510	3615	Lime & Shale
3615	3657	Lime
RTD	3657	

STATE OF KANSAS )  
                          ) ss.  
COUNTY OF SEDGWICK)

RECEIVED  
STATE CORPORATION COMMISSION

MAY 20 1981

CONSERVATION DIVISION

I, Burke Krueger, of Thunderbird Drilling, Wichita, Kansas, on oath states that the above and foregoing is a true and correct copy from the Daily Drilling Report from your #1 Sizemore

*Burke Krueger*

Subscribed and sworn to before me this 15th day of May, 1981

*Gloria DeJesus*  
Gloria DeJesus Notary Public

My commission expires: 3-25-84

