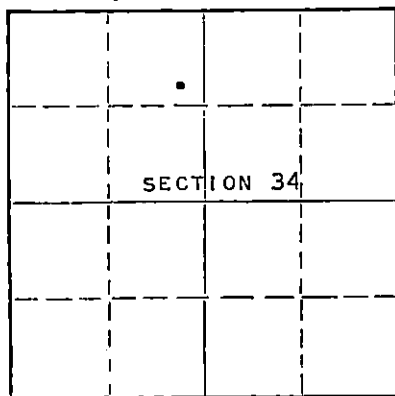


STATE OF KANSAS
STATE CORPORATION COMMISSIONGive All Information Completely
Make Required Affidavit
Mail or Deliver Report to:
Conservation Division
State Corporation Commission
211 No. Broadway
Wichita, Kansas

WELL PLUGGING RECORD

NORTH

Locate well correctly on above
Section PlatSTAFFORD County. Sec. 34 Twp. 22s. Rge. 14 (E) (W)
Location as "NE/CNW/SW" or footage from lines SE NE NW
Lease Owner PETROLEUM, INC.,
Lease Name KEELEY "D" Well No. 1
Office Address ROUTE #2, GREAT BEND, KANSAS
Character of Well (completed as Oil, Gas or Dry Hole) DRY HOLE
Date well completed MARCH 5 19 64
Application for plugging filed MARCH 5 19 64
Application for plugging approved MARCH 5 19 64
Plugging commenced MARCH 5 19 64
Plugging completed MARCH 5 19 64
Reason for abandonment of well or producing formation NO PRODUCIBLE ZONESIf a producing well is abandoned, date of last production 19
Was permission obtained from the Conservation Division or its agents before plugging was commenced? YESName of Conservation Agent who supervised plugging of this well ARCHIE V. ELVING, PRATT, KANSAS
Producing formation - Depth to top - Bottom - Total Depth of Well 3740 Feet
Show depth and thickness of all water, oil and gas formations.

OIL, GAS OR WATER RECORDS

CASING RECORD

FORMATION	CONTENT	FROM	TO	SIZE	PUT IN	PULLED OUT
				8-5/8"	258'	NONE

Describe in detail the manner in which the well was plugged, indicating where the mud fluid was placed and the method or methods used in introducing it into the hole. If cement or other plugs were used, state the character of same and depth placed, from feet to feet for each plug set.

MUDDED UP WITH HEAVY MUD TO 250', FOLLOWED BY A WOODEN PLUG AND 1/4 SACK HULLS. PLACED 25 SACKS CEMENT ON TOP OF HULLS. MUDDED UP WITH HEAVY MUD TO 40', FOLLOWED BY A WOODEN PLUG AND 1/2 SACK HULLS. PLACED 10 SACKS ON TOP OF HULLS TO BASE OF WELL CELLAR.

RECEIVED
STATE CORPORATION COMMISSION

MAR 13 1964

CONSERVATION DIVISION
Wichita, Kansas

3-13-64

(If additional description is necessary, use BACK of this sheet)

Name of Plugging Contractor GARVEY DRILLING COMPANY
Address ROUTE #2, GREAT BEND, KANSASSTATE OF KANSAS, COUNTY OF BARTON, ss.
MONTE CHADD (employee of owner) or (owner) of the above-described well, being first duly sworn on oath, says: That I have knowledge of the facts, statements, and matters herein contained and the log of the above-described well as filed and that the same are true and correct. So help me God. MONTE CHADD, DIST. PROD. SUPT.
(Signature)R.R. #2, GREAT BEND, KANSAS
(Address)

SUBSCRIBED AND SWORN TO before me this 10TH day of MARCH 19 64

My commission expires SEPTEMBER 23, 1967

Notary Public.

WELL LOG

15.185-11874-0000

COMPANY Petroleum, Inc.

SEC. 34 T.22S R. 14W

FARM Keeley

NO. D-1

LOC. SE NE NW


TOTAL DEPTH 3740'

COUNTY Stafford

COMM. 2-27-64

COMP. 3-5-64

CONTRACTOR Garvey Drilling Company

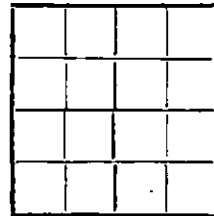

CASING .8 5/8" @ 258' w/225 sx

ELEVATION 1944' DF

PRODUCTION D & A

FIGURES INDICATE BOTTOM OF FORMATIONS

40 Sand
155 Sand and Shale
258 Blue Shale
850 Shale and Red Bed
875 Anhydrite
1655 Shale and Shells
1860 Lime and Shale
2330 Lime
2545 Lime and Shale
2805 Shale w/Lime Streaks
3155 Shale and Lime
3295 Lime
3410 Lime w/Shale Streaks
3740 Lime
3740 RTD

RECEIVED
STATE CORPORATION COMMISSION

MAR 13 1964

CONSERVATION DIVISION
Wichita, Kansas

State of Kansas }
County of Barton } ss

I, Sam N. Stephens of Garvey Drilling Company
upon oath state the above and foregoing is a true and correct copy of the log of the Keeley D-1 well.

Subscribed and sworn to before me this 11th day of March 19 64

My Commission Expires: September 23rd, 1967

NOTARY PUBLIC