


STATE OF KANSAS
STATE CORPORATION COMMISSION

WELL PLUGGING RECORD

Give All Information Completely
Make Required Affidavit
Mail or Deliver Report to
Conservation Division
State Corporation Comm.
245 North Water
Wichita, KS 67202

Stafford County, Sec. 17 Twp. 22 Rge. 14 ^XE/W
Location as "NE/CNW/SW" or footage from lines
SW NE NW

Lease Owner F & M Oil Co., Inc.
Lease Name Blackwell Well No. 1
Office Address 422 Union Center, Wichita, Ks. 672022
Character of Well (Completed as Oil, Gas or Dry Hole)
Dry Hole

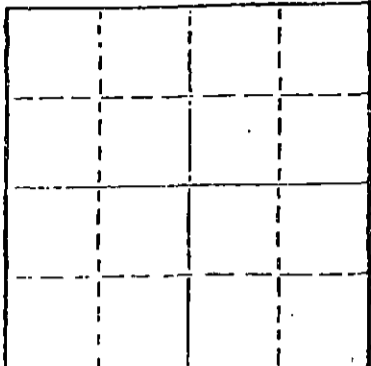

Locate well correctly on above
Section Plot

Date Well completed Aug. 22 1981
Application for plugging filed Aug. 22 1981
Application for plugging approved Aug. 22 1981
Plugging commenced Aug. 22 1981
Plugging completed Aug. 22 1981
Reason for abandonment of well or producing formation
Dry Hole

If a producing well is abandoned, date of last production
19.

Was permission obtained from the Conservation Division or
its agents before plugging was commenced? yes

Name of Conservation Agent who supervised plugging of this well Bud Metz
Producing formation _____ Depth to top _____ Bottom _____ Total Depth of Well 3960
Show depth and thickness of all water, oil and gas formations.

OIL, GAS OR WATER RECORDS

CASING RECORD

FORMATION	CONTENT	FROM	TO	SIZE	PUT IN	PULLED OUT
				8 5/8"	564'	non

Describe in detail the manner in which the well was plugged, indicating where the mud fluid
was placed and the method or methods used in introducing it into the hold. If cement or other
plugs were used, state the character of same and depth placed, from _____ feet to
_____ feet for each plug set.

1st plug @ 600' w/60 sacks cement
2nd plug @ 240' w/40 sacks cement
Top plug @ 40' w/10 sacks cement
10 sacks cement in rat hole
50/50 Pozmix, 3% cc.

RECEIVED
STATE CORPORATION COMMISSION

AUG 25 1981

(If additional description is necessary, use BACK of this sheet)
Name of Plugging Contractor Mustang Drilling & Exploration, Inc.
Wichita, Kansas

STATE OF KANSAS COUNTY OF BARTON, ss.
Milford Martin (employee of owner) or ~~(xxxxxx)~~

of the above-described well, being first duly sworn on oath, says: That I have knowledge of
the facts, statements, and matters herein contained and the log of the above-described well
as filed and that the same are true and correct. So help me God.

(Signature) Milford Martin
Box 1609, Great Bend, Kansas 67530
(Address)

SUBSCRIBED AND SWORN TO before me this 24th day of Aug., 1981

BEVERLY SHEWBART
Barton County, Kansas
My Appt. Exp. April 14, 1982

Beverly Shewbart
Notary Public.

My commission expires _____

DRILLERS' WELL LOG

DATE COMMENCED: August 15, 1981
 DATE COMPLETED: August 22, 1981

F & M Oil Co., Inc.
 "BLACKWELL # 1"
 SW NE NW
 Sec 17-T22-R14W
 Stafford County, Kansas
 API # 15-185-21,394

0 - 340' Sand, Shale
 340 - 430' D. Sand
 430 - 565' Shale, Sand Streaks
 565 - 1675' Shale
 1675 - 3374' Lime, Shale
 3374 - 3380' Shale
 3380 - 3396' Lime, Shale
 3396 - 3413' Lime
 3413 - 3498' Shale
 3498 - 3506' Lime, Shale
 3506 - 3742' Lime
 3742 - 3822' Lime, Shale
 3822 - 3887' Lime
 3887 - 3903' Shale
 3903 - 3951' Sand
 3951 - 3960' Dolomite
 3960' RTD

ELEVATION: 1956 GL 1966 KB

FORMATION TOPS (log)

Anhydrite	883	+1083
Howard	2925	-959
Topeka	2991	-1025
Heebner	3374	-1408
Toronto	3396	-1430
Douglas	3413	-1447
Brown Lime	3498	-1532
Lansing	3506	-1540
Base K.C.	3742	-1776
Viola	3822	-1856
Simpson Shale	3887	-1921
Simpson Sand	3903	-1937
Arbuckle	3951	-1985
RTD	3960	-1994

SURFACE PIPE:
 Set new 8 5/8", 24# pipe at 564'
 w/350 sacks Common, 3% cc, 2% gel.

RECEIVED
 STATE CORPORATION COMMISSION
 AUG 27 1981
 CONSERVATION DIVISION
 Wichita, Kansas

A F F I D A V I T

STATE OF KANSAS
 COUNTY OF BARTON, ss.

I, Milford Martin, of Mustang Drilling & Exploration, Inc. do state that
 the above is true and correct to the best of my knowledge.

Milford Martin
 Milford Martin,

Subscribed and sworn to before me this 24th day of August, 1981.

Beverly Shewbart
 Beverly Shewbart, Notary Public

My Appointment Expires:

STATE OF KANSAS NOTARY PUBLIC	BEVERLY SHEWBART
My App. Exp. _____	AD 11 14 1982