

WELL PLUGGING RECORD

Give All Information Completely
Make Required Affidavit
Mail or Deliver Report to:
Conservation Division
State Corporation Commission
800 Biting Buik, g
Wichita, Kansas

Stafford County. Sec. 33 Twp. 22 Rge. 14 ~~E~~ W (W)

Location as "NE/CNW/SW" or footage from lines SE-SE-SW

Lease Owner PETROLEUM, Incorporated

Lease Name Wood Well No. 1

Office Address 311 East Third, Wichita, Kansas

Character of Well (completed as Oil, Gas or Dry Hole) Oil

Date well completed June 23, 19 53

Application for plugging filed February 23 19 55

Application for plugging approved February 28 19 55


Plugging commenced March 10 19 55

Plugging completed March 21 19 55

Reason for abandonment of well or producing formation Depletion of producible zones

If a producing well is abandoned, date of last production January 9 19 55

Was permission obtained from the Conservation Division or its agents before plugging was commenced? Yes

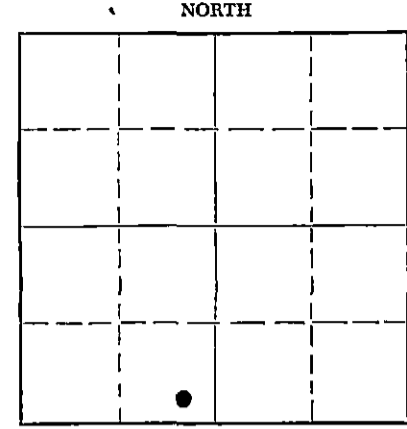

Locate well correctly on above Section Plat

Name of Conservation Agent who supervised plugging of this well M. A. Rives, Pratt, Kansas

Producing formation Simpson Depth to top 3901' Bottom 3965' Total Depth of Well 4015' Feet

Show depth and thickness of all water, oil and gas formations.

OIL, GAS OR WATER RECORDS				CASING RECORD		
FORMATION	CONTENT	FROM	TO	SIZE	PUT IN	PULLED OUT
Arbuckle	Oil & water	3,967'	3,968'	8-5/8" OD	217'	NONE
Simpson	Oil & water	3,929'	3,936'	5 1/2" OD	4,014'	2,946'

Describe in detail the manner in which the well was plugged, indicating where the mud fluid was placed and the method or methods used in introducing it into the hole. If cement or other plugs were used, state the character of same and depth placed, from _____ feet to _____ feet for each plug set.

(Plugged back to 3,943')

Filled hole with crushed rock from 3943' to 3915'. Run 5 sacks cement from 3915' to 3880'. Filled hole with heavy mud from 3880' to 225' and placed solid rock bridge from 225' to 215'. Run 20 sacks cement from 215' to 175' and filled hole with heavy mud from 175' to 50'. Placed rock bridge from 50' to 35'. Capped with 10 sacks cement from 35' to base of well cellar.

(If additional description is necessary, use BACK of this sheet)

Name of Plugging Contractor Morgan Well Plugging Service (License #43)
Address 102 West 18th Street, Hutchinson, Kansas

STATE OF Kansas, COUNTY OF Barton, ss.
Paul B. Shivel (employee of owner) or (owner representative) of the above-described well, being first duly sworn on oath, says: That I have knowledge of the facts, statements, and matters herein contained and the log of the above-described well as filed and that the same are true and correct. So help me God.
(Signature) Paul B. Shivel
Rural Route 2, Great Bend, Kansas (Address)

SUBSCRIBED AND SWORN TO before me this 30th day of March 19 55
Goy E. Anderson (Signature)
Notary Public.

My commission expires November 21, 1957

PLUGGING
FILE SEC 33 Twp 22 Rge 14
BOOK PAGE 19 LINE 42

RECEIVED
STATE CORPORATION COMMISSION
APR - 2 1955
CONSERVATION DIVISION
Wichita, Kansas

DRILLER'S LOG WOOD NO. 1

Petroleum, Inc., Operator
Garvey Drilling Company, Contractor

Section 33, Twp. 22S, Rge. 14W
Location: SE SE SW
County: Stafford County, Kansas
R.T.D.: 4015'

Drilling Commenced: May 30, 1953
Drilling Completed: June 13, 1953
Casing Record: 8 5/8" @ 219' w/200 sax
5 1/2" @ 4014' w/125 sax

Figures below indicate bottom of formation

40 Surface soil
165 Sand & Shale
320 Shale
410 Sand
856 Shale & Shells
887 Anhydrite
1750 Shale & Shells
3489 Lime & Shale
3509 Shale
3660 Lime & Shale
3713 Lime
3840 Lime & Shale
3890 Lime, Shale & Chert
3901 Chert
3940 Shale & Sand
3955 Lime & Shale
3970 Shale & Sand
4015 Lime

Tops:

Heebner: 3388 (-1493)
Brown Line: 3509 (-1554)
Lansing: 3518 (-1563)
Simpson: 3901 (-1946)
Arbuckle: 3965 (-2010)

4015' R.T.D.

I hereby certify that this is a true and correct log of the above mentioned well.

PETROLEUM, INC.

By W. W. Fish

STATE OF KANSAS)
COUNTY OF SEDGWICK)

SS:

RECEIVED
STATE CORPORATION COMMISSION

APR - 2 1955

Subscribed to and sworn to before me, a Notary Public, in Sedgwick County and State, this 24th day of June, 1953.

CONSERVATION DIVISION
Wichita, Kansas

Charlotte Sherman
Notary Public

My commission expires: October 13, 1954.

PLUGGING
FILE SEC. 33-22-R-14W
BOOK PAGE 97 LINE 42