


STATE OF KANSAS  
STATE CORPORATION COMMISSION

WELL PLUGGING RECORD

Give All Information Completely  
Make Required Affidavit  
Mail or Deliver Report to:  
Conservation Division  
State Corporation Commission  
500 Bitting Building  
Wichita, Kansas

Stafford County, Sec. 33 Twp. 22S Rge. 11 (E) (W)  
Location as "NE/CNW $\frac{1}{4}$ SW $\frac{1}{4}$ " or footage from lines NW NW SW  
Lease Owner John Lindas Oil, Inc  
Lease Name Wood Well No. 1  
Office Address 1316 Union National Bank Bldg., Wichita, Kansas  
Character of Well (completed as Oil, Gas or Dry Hole) Dry  
Date well completed 12-30-51 19  
Application for plugging filed 12-30-51 19  
Application for plugging approved " 19  
Plugging commenced " 19  
Plugging completed " 19  
Reason for abandonment of well or producing formation Dry

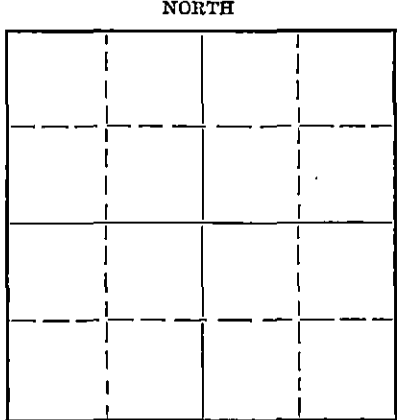

If a producing well is abandoned, date of last production 19  
Was permission obtained from the Conservation Division or its agents before plugging was commenced? YES

Name of Conservation Agent who supervised plugging of this well C. D. Stough  
Producing formation Depth to top Bottom Total Depth of Well 4110 Feet  
Show depth and thickness of all water, oil and gas formations.

OIL, GAS OR WATER RECORDS

CASING RECORD

Formation	Content	From	To	Size	Put In	Pulled Out
				8-5/8	22 1/2	none

Describe in detail the manner in which the well was plugged, indicating where the mud fluid was placed and the method or methods used in introducing it into the hole. If cement or other plugs were used, state the character of same and depth placed, from feet to feet for each plug set.

Filled hole w/ mud to 220', 15 sacks cement, filled hole to 35', 10 sacks cement

JAN - 3 1952 1-3-52  
Conservation Division  
Wichita, Kansas

(If additional description is necessary, use BACK of this sheet)

Correspondence regarding this well should be addressed to John Lindas Oil, Inc.  
Address 1316 Union National Bank Building, Wichita, Kansas

STATE OF KANSAS, COUNTY OF SEDGWICK, ss.  
I, Edward W. Wiens (employee of owner) or (owner or operator) of the above-described well, being first duly sworn on oath, says: That I have knowledge of the facts, statements, and matters herein contained and the log of the above-described well as filed and that the same are true and correct. So help me God.

(Signature) Edward W. Wiens  
1316 Union National Bank Bldg., Wichita, Kansas (Address)

SUBSCRIBED AND SWORN to before me this 31st day of December, 1951.

Catherine Duran  
Notary Public.

My commission expires March 25, 1952.

33-22-14W  
135-8

DRILLING LOG

To: Lion Oil Company  
 Sunray Oil Corporation  
 National Cooperative Refinery Association  
 Prairie States Oil Company  
 Garshaw Oil Company  
 John D. McEwen  
 Justin Riley  
 Edward G. Siebert  
 Dr. Hugh Hamilton  
 John Lindas Oil, Inc.

Lease: Wood #1

County: Stafford  
 Location: SW  $\frac{1}{4}$   
 Section: 33-22-11W  
 Elevation: 1961' KB 1958' DF

Rotary Total Depth: 4110'  
 Commenced: 12-15-51; Completed: 12-31-51  
 Casing: 8 5/8" @ 224' with 150 sacks of cement and 2 sacks of calcium chloride.

Contractor: John Lindas Oil, Inc. Rig #3  
 1316 Union National Bank Building  
 Wichita 2, Kansas.

FIGURES INDICATE BOTTOM OF FORMATION

0	to	60	Surface Soil and Sand
60		130	Chat and Sand
130		325	Shale
325		425	Sand
425		875	Red Bed
875		905	Anhydrite
905		1825	Shale and Shells
1825		1900	Lime
1900		2080	Lime and Shale
2080		2230	Shale and Shells
2230		2300	Lime and Shale
2300		2390	Shale and Lime Streaks
2390		2840	Lime and Shale
2840		2880	Rough Broken Lime
2880		3115	Lime and Shale
3115		3230	Sandy Lime and Shale
3230		3290	Shale
3290		3405	Lime
3405		3575	Lime and Shale
3575		3862	Lime
3862		3950	Lime Conglomerate
3950		3985	Lime and Shale
3985		4030	Sandy Lime and Shale
4030		4033	Shale
4033		4050	Arbuckle Lime
4050		4110	Arbuckle Lime

**PLUGGING**  
 FILE SEC 33 T 22 R 14W  
 BLOCK PAGE 125 LINE 8

STATE OF KANSAS )  
 )ss  
 COUNTY OF SEDEWICK)

RECEIVED  
 STATE COMMISSIONER OF GEOLOGY  
 JAN - 8 1952  
 CONSERVATION DIVISION  
 Wichita, Kansas

I, the undersigned, being duly sworn on oath, state that the above statement and log is a true and correct record of the well drilled by John Lindas Oil, Inc. at the location above described.

*Edward W. Wiers*

Subscribed and sworn to before me, this 31st day of December, 1951.

*Catherine Dancy*

My commission expires March 25, 1952.