

STATE OF KANSAS
STATE CORPORATION COMMISSION

WELL PLUGGING RECORD

Give All Information Completely
Make Required Affidavit
Mail or Deliver Report to
Conservation Division
State Corporation Comm.
245 North Water
Wichita, KS 67202

Stafford County, Sec. 33 Twp. 22 Rge. 14 E/W
Location as "NE/CNW $\frac{1}{4}$ /SW $\frac{1}{4}$ " or footage from lines _____

SW SE SW
Lease Owner Eagle Petroleum
Lease Name HARTMAN Well No. 1


Office Address 1400 Douglas Bldg., Wichita, Ks.
Character of Well (Completed as Oil, Gas or Dry Hole)
Dry Hole

Date Well completed 3-15-1979
Application for plugging filed 3-15-1979
Application for plugging approved 3-15-1979
Plugging commenced 3-15-1979
Plugging completed 3-15-1979
Reason for abandonment of well or producing formation _____

If a producing well is abandoned, date of last production 19__

Was permission obtained from the Conservation Division or its agents before plugging was commenced? yes

Name of Conservation Agent who supervised plugging of this well William Owen
Producing formation _____ Depth to top _____ Bottom _____ Total Depth of Well 4010
Show depth and thickness of all water, oil and gas formations.

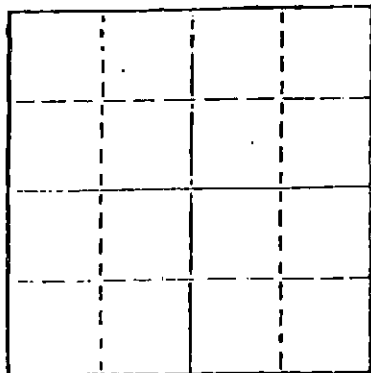

Locate well correctly on above Section Plot

OIL, GAS OR WATER RECORDS

CASING RECORD

FORMATION	CONTENT	FROM	TO	SIZE	PUT IN	PULLED OUT

Describe in detail the manner in which the well was plugged, indicating where the mud fluid was placed and the method or methods used in introducing it into the hold. If cement or other plugs were used, state the character of same and depth placed, from _____ feet to _____ feet for each plug set.

Bottom plug set @ 540' w/50 sacks 50/50 pozmix thru drill pipe
Middle plug set @ 270' w/40 sacks " " " " " "
Top plug set @ 40' w/solid bridge $\frac{1}{2}$ sk hulls & 12 sks. cement
3 sacks cement in rat hole

RECEIVED
STATE CORPORATION COMMISSION
MAR 20 1979

CONSERVATION DIVISION
Wichita, Kansas

(If additional description is necessary, use BACK of this sheet)

Name of Plugging Contractor Duke Drilling Co., Inc.

STATE OF KANSAS COUNTY OF BARTON, ss.
Bill Draney (employee of owner) or (owner or operator)
of the above-described well, being first duly sworn on oath, says: That I have knowledge of the facts, statements, and matters herein contained and the log of the above-described well as filed and that the same are true and correct. So help me God.

(Signature) Bill Draney
Box 823 - Great Bend, Ks. 67530
(Address)

SUBSCRIBED AND SWORN TO before me this 19 day of March, 19 79

X *Donald M. Hague*
Notary Public.

My commission expires 4-11-1982

DRILLERS' WELL LOG

DATE COMMENCED: March 6, 1979
DATE COMPLETED: March 15, 1979

Eagle Petroleum
Hartman # 1
SW SW SW
Sec. 33, -T22S-R14W
Stafford Co., Ks.

0 - 105'	Sand
105 - 325'	Shale
325 - 400'	Sand
400 - 867'	Shale
867 - 897'	Anhydrite
897 - 3396'	Shale & Lime
3398 - 3403'	Shale
3403 - 3420'	Lime & Shale
3420 - 3437'	Lime
3437 - 3528'	Shale
3528 - 3540'	Lime and Shale
3540 - 3830'	Lime
3830 - 3832'	Lime - Shale
3832 - 3935'	Chert
3935 - 3958'	Shale
3958 - 3995'	Sand, Shale, Lime
3995 - 4010'	Dolomite
4010'	RTD

ELEVATION: 1957 K.B.

FORMATION DATA

Anhydrite	867
Hochman	3396
Toronto	3420
Douglas	3437
Br. Lime	3528
Lansing - K.C.	3540
Base - K.C.	3830
Conglomerate	3850
Viola	3832
Simpson	3935
Simpson Sd.	3958
Arbuckle	3995
RTD	4010

SURFACE PIPE: Set
used 6 5/8", 20# pipe
@ 277' w/225 sacks 60/40
pozzix, 2% gel, 3% cc.

AFFIDAVIT

STATE OF KANSAS
COUNTY OF BARTON) ss

Bill Draney, of lawful age does swear and state that the facts and
statements herein contained are true and correct to the best of his knowledge.

Bill Draney

Subscribed and sworn to before me this 19 day of March 1979

Llewellyn M. Hague
Notary Public

My Comm. Expires:
April 11, 1982

RECEIVED
STATE CORPORATION COMMISSION

MAR 20 1979

CONSERVATION DIVISION
Wichita, Kansas