


WELL PLUGGING RECORD

Give All Information Completely
Make Required Affidavit
Mail or Deliver Report to:
Conservation Division
State Corporation Commission
800 Bitting Building
Wichita, Kansas

Stafford County, Sec. 19 Twp. 22S Rge. (E) 14 (W)
Location as "NE/CNW/SW" or footage from lines NE NW SE
Lease Owner Natural Gas and Oil Company, etal
Lease Name Carr Well No. 1
Office Address 1009 Central Building, Wichita 2, Kansas
Character of Well (completed as Oil, Gas or Dry Hole) dry hole
Date well completed November 7, 1954 19
Application for plugging filed (orally) November 7, 1954 19
Application for plugging approved " November 7, 1954 19
Plugging commenced November 7, 1954 19
Plugging completed November 7, 1954 19
Reason for abandonment of well or producing formation

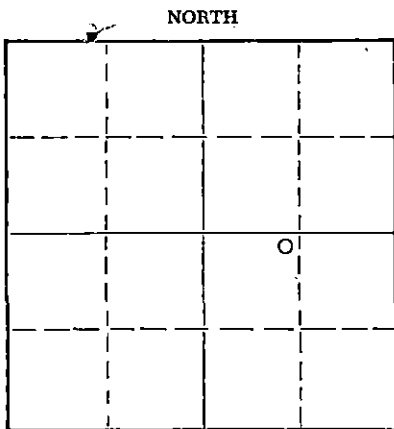

Locate well correctly on above Section Plat

If a producing well is abandoned, date of last production 19
Was permission obtained from the Conservation Division or its agents before plugging was commenced? yes

Name of Conservation Agent who supervised plugging of this well Warren H. Horner, Box 207, Great Bend, Kans.

Producing formation Depth to top Bottom Total Depth of Well Feet

Show depth and thickness of all water, oil and gas formations.

OIL, GAS OR WATER RECORDS

CASING RECORD

FORMATION	CONTENT	FROM	TO	SIZE	PUT IN	PULLED OUT
Surface		0	210	8 5/8"	310'	none

Describe in detail the manner in which the well was plugged, indicating where the mud fluid was placed and the method or methods used in introducing it into the hole. If cement or other plugs were used, state the character of same and depth placed, from feet to feet for each plug set.

Filled hole with heavy mud from total depth 4051 to 210 feet
Set plug at 210' and ran 20 sacks cement to 150'
Filled hole with heavy mud from 150' to 30'
Set plug at 30 feet and capped with 10 sacks cement.

11-17-54

(If additional description is necessary, use BACK of this sheet)

Name of Plugging Contractor Harms-Burt Drilling Company
Address P O Box 184, Great Bend, Kansas

STATE OF Kansas COUNTY OF Sedgwick ss.
John D. Carey (employee of owner) of ~~Kansas~~ of the above-described


well, being first duly sworn on oath, says: That I have knowledge of the facts, statements and the log of the above-described well as filed and that the same are true and correct. So help me God.

(Signature) John D. Carey
1009 Central Building, Wichita 2, Kansas
(Address)

SUBSCRIBED AND SWORN to before me this 12th day of November, 1954

Esther Unsell
Notary Public.

My commission expires May 25, 1957

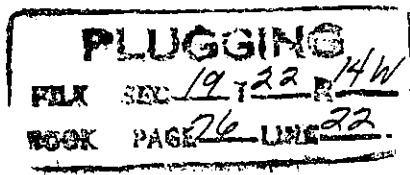

DRILLER'S LOG

COMPANY: Natural Gas and Oil Company, a
Division of Mississippi River
Fuel Corporation, etal

CONTRACTOR: Harms-Burt Drilling Company

FARM: Carr #1, NE NW SE Sec. 19-22S-14W
Stafford County, Kansas

COMMENCED: October 25, 1954

COMPLETED: November 7, 1954

ELEVATION: 1965 RB

0 to 40 Clay and sand
40 to 120 Sand
120 to 355 Shale and shells
355 to 425 Sand
425 to 897 Red Bed
897 to 925 Anhydrite
925 to 1120 Shale and shells
1120 to 1690 Shale, shells & Salt
1690 to 1960 Lime and shale
1960 to 2220 Lime
2220 to 2915 Lime and shale
2915 to 3020 Lime
3020 to 3090 Lime and shale
3090 to 3275 Lime
3275 to 3588 Lime and shale
3588 to 3765 Lime
3765 to 3874 Lime and shale
3874 to 3952 Conglomerate
3952 to 3963 Lime
3963 to 4015 Lime and shale
4015 to 4021 Shale
4021 to 4050 Arbuckle lime
4050 T.D. (RB)

Set 210 feet of 8 5/8" surface pipe. Cemented with 225 sacks cement and 5 sacks calcium chloride.

No drill stem tests.

TOPS:	Sample		Schlumberger	
	Heebner	3400	Heebner	3396
	Brown Lime	3524	Brn lime	3521
	Lansing	3538	Lansing	3534
Base KC	3765	Simpson	3965	Base KC
Viola	3895	Arbuckle	4021	Viola
				Simpson
				Arbuckle
				4018

Ran Schlumberger

DRY, PLUGGED AND ABANDONED

C E R T I F I C A T E

I, Claud L. Sheats, do hereby certify that the above and foregoing is a true and correct copy of the log of the Carr #1, NE NW SE Section 19, 22S-14W, Stafford County, Kansas, as reflected by files of the Natural Gas and Oil Company, a division of Mississippi River Fuel Corporation.

PLUGGING
FILE SEC 19, 22S, 14W
BOOK PAGE 26, LINE 22

Claud L. Sheats
Claud L. Sheats

Subscribed and sworn to before me, a Notary Public, within and for Sedgwick County, Kansas, this 16th day of November, 1954.

Esther Unsell

My Commission expires May 25, 1957-Esther Unsell, Notary Public