


WELL PLUGGING RECORD

Give All Information Completely
Make Required Affidavit
Mail or Deliver Report to:
Conservation Division
State Corporation Commission
211 No. Broadway
Wichita, Kansas

Stafford County, Sec. 32 Twp. 22 Rge. 14 (W)
Location as "NE/CNW/SW" or footage from lines SW SE NW
Lease Owner D.R. Lauck Oil Company, Inc.
Lease Name McAllister Well No. 1
Office Address Wichita Kansas
Character of Well (completed as Oil, Gas or Dry Hole) dry hole
Date well completed February 6 19 56
Application for plugging filed February 6 19 56
Application for plugging approved February 6 19 56
Plugging commenced February 6 19 56
Plugging completed February 6 19 56
Reason for abandonment of well or producing formation dry hole
If a producing well is abandoned, date of last production - - 19 - -
Was permission obtained from the Conservation Division or its agents before plugging was commenced? yes

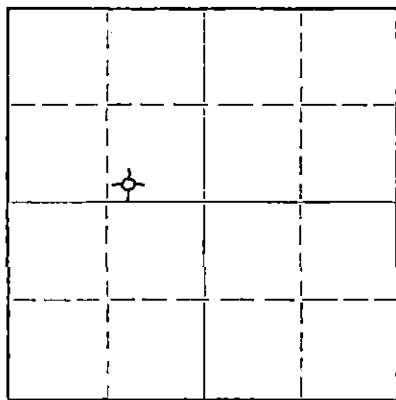

Locate well correctly on above Section Plat

Name of Conservation Agent who supervised plugging of this well R. M. Brundage
Producing formation _____ Depth to top _____ Bottom _____ Total Depth of Well 4057 Feet
Show depth and thickness of all water, oil and gas formations.

OIL, GAS OR WATER RECORDS

CASING RECORD

FORMATION	CONTENT	FROM	TO	SIZE	PUT IN	PULLED OUT
		0	222'	8 5/8"	222'	none

Describe in detail the manner in which the well was plugged, indicating where the mud fluid was placed and the method or methods used in introducing it into the hole. If cement or other plugs were used, state the character of same and depth placed, from _____ feet to _____ feet for each plug set.

hole filled with mud;
100 sacks of cement pumped on top of plug;

2-16-56

(If additional description is necessary, use BACK of this sheet)
Name of Plugging Contractor Sun Cementing Co.
Address Great Bend Kansas


STATE OF Kansas, COUNTY OF Sedgwick, ss.
John H. Knightley (employee of owner) ~~or power operator~~ of the above-described well, being first duly sworn on oath, says: That I have knowledge of the facts, statements, and matters herein contained and the log of the above-described well as filed and that the same are true and correct. So help me God.

(Signature) John H. Knightley
Wichita Kansas
(Address)

SUBSCRIBED AND SWORN TO before me this 10 day of February, 19 56

My commission expires Sept. 14, 1959

Elizabeth Ray
Notary Public.

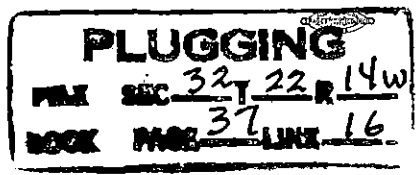

D. R. Lauck Oil Company, Inc.
& Sunray Mid-Continent Oil Company

#1 McAllister

SW SE NW Sec. 32-22S-14W
Stafford County Kansas

Commenced: January 22, 1956
Completed: February 6, 1956

Elevation: GR 1960; DF 1963; KB 1965;

Casing Record: 222' 8 5/8" cem.w/175 sax

Drillers Log

Tops
Sample Halliburton

Sand	90	Anhydrite (Driller)	855+1110	
sand & shale	175	Heebner	3394-1429	3397-1432
shale & shells	312	Brown Lime	3527-1562	3531-1566
sand	415	Lansing	3537-1572	3542-1577
red bed & shells	855	Base K.C.	3771-1806	3772-1807
Anhydrite	880	Viola	3886-1921	3896-1931
shale & shells	1150	Simpson	3974-2009	3982-2017
salt & shale	1350	Arbuckle	4032-2067	4040-2075
shale & shells	1785	Rotary Total Depth	4057-2092	4059-2094
lime & shale	2585			
shale & shells	2600			
lime & shale	3150			
lime	3180			
lime & shale	3405			
shale	3527			
lime	3850			
shale & chert	3885			
lime & chert	3916			
chert	3931			
lime & chert	3955			
lime & shale	4000			
lime	4057			
RTD	4057			

D & A

