

STATE OF KANSAS  
STATE CORPORATION COMMISSION


Form CP-4

WELL PLUGGING RECORD

Give All Information Completely  
Make Required Affidavit  
Mail or Deliver Report to:  
Conservation Division  
State Corporation Commission  
212 No. Market  
Wichita, Kansas

STAFFORD County, Sec. 24 Twp. 22S Rge. 13 (E) (W)

NORTH

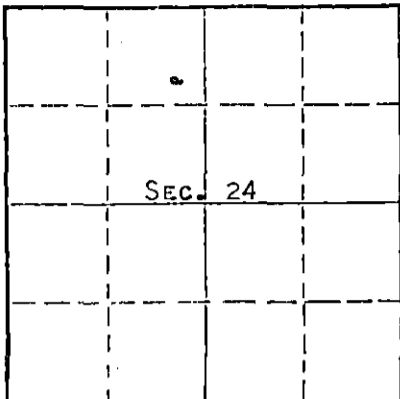

Locate well correctly on above Section Plat

Location as "NE/CNW/SW" or footage from lines SE NE NW  
Lease Owner PETROLEUM, INC.  
Lease Name UKENS 'G' Well No. 1  
Office Address R.R. #2, GREAT BEND, KANSAS  
Character of Well (completed as Oil, Gas or Dry Hole) DRY HOLE  
Date well completed MARCH 30 1967  
Application for plugging filed MARCH 30 1967  
Application for plugging approved MARCH 30 1967  
Plugging commenced MARCH 30 1967  
Plugging completed MARCH 30 1967  
Reason for abandonment of well or producing formation NO PRODUCIBLE ZONE

If a producing well is abandoned, date of last production NONE 19  
Was permission obtained from the Conservation Division or its agents before plugging was commenced? YES

Name of Conservation Agent who supervised plugging of this well ARCHIE ELVING  
Producing formation \_\_\_\_\_ Depth to top \_\_\_\_\_ Bottom \_\_\_\_\_ Total Depth of Well 3775 Feet  
Show depth and thickness of all water, oil and gas formations.

OIL, GAS OR WATER RECORDS

CASING RECORD

FORMATION	CONTENT	FROM	TO	SIZE	PUT IN	PULLED OUT
				8-5/8"	284'	NONE

Describe in detail the manner in which the well was plugged, indicating where the mud fluid was placed and the method or methods used in introducing it into the hole. If cement or other plugs were used, state the character of same and depth placed, from \_\_\_\_\_ feet to \_\_\_\_\_ feet for each plug set.

MUD TO 250', FOLLOWED BY WOODEN PLUG, PLACED 1/2 SACK HULLS, 25 SACKS CEMENT ON TOP OF PLUG. MUD TO 40', FOLLOWED BY WOODEN PLUG, PLACED 1/2 SACK HULLS AND 10 SACKS CEMENT ON TOP OF PLUG.

RECEIVED  
STATE CORPORATION COMMISSION

APR 5 1967

CONSERVATION DIVISION  
Wichita, Kansas

(If additional description is necessary, use BACK of this sheet)  
Name of Plugging Contractor GARVEY DRILLING COMPANY  
Address R.R. #2, GREAT BEND, KANSAS

STATE OF KANSAS, COUNTY OF BARTON, ss.  
MONTE CHADD (employee of owner) or (owner or operator) of the above-described well, being first duly sworn on oath, says: That I have knowledge of the facts, statements, and matters herein contained and the log of the above-described well as filed and that the same are true and correct. So help me God. MONTE CHADD, DIST. PROD. SUPT.

(Signature) *Monte Chadd*  
R.R. #2, GREAT BEND, KANSAS  
(Address)

SUBSCRIBED AND SWORN to before me this 4 day of APRIL, 19 67

*Richard A. D... ..*  
Notary Public.

# WELL LOG

COMPANY Petroleum, Inc.

SEC. 24 T. 22S R. 13W

FARM Ukens

NO. G-1

LOC. SE NE NW


TOTAL DEPTH 3775'

COUNTY Stafford

COMM. 3-20-67

COMP. 3-30-67

CONTRACTOR Garvey Drilling Company

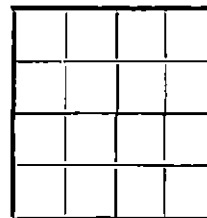

CASING 8 5/8" @ 284' w/500 sx

ELEVATION 1880' DF

PRODUCTION D & A

FIGURES INDICATE BOTTOM OF FORMATIONS

- 75' Surface Soil and Sand
- 235' Sand and Shale
- 285' Red Bed
- 815' Shale and Shells
- 1500' Red Bed and Shale
- 2290' Lime and Shale
- 2535' Shale and Lime
- 2855' Shale with Lime Streaks
- 3170' Lime and Shale
- 3305' Shale and Lime
- 3350' Lime and Shale
- 3540' Lime
- 3580' Lime and Shale
- 3605' Lime
- 3703' Lime and Chert
- 3740' Shale and Sand
- 3745' Sand
- 3760' Simpson Sand and Shale
- 3775' Lime and Shale
- 3775' RTD

**RECEIVED**  
 STATE OF KANSAS  
 APR 5 1967  
 CONSERVATION DIVISION  
 Wichita, Kansas

State of Kansas }  
 County of Barton } SS

I, Sam N. Stephens of Garvey Drilling Company

upon oath state the above and foregoing is a true and correct copy of the log of the Ukens G-1 well.

*Sam N. Stephens*

Subscribed and sworn to before me this 3rd day of April 19 67

My Commission Expires: November 5th, 1969

*Richard Doep*  
 NOTARY PUBLIC