


WELL PLUGGING RECORD

Give All Information Completely  
Make Required Affidavit  
Mail or Deliver Report to:  
Conservation Division  
State Corporation Commission  
800 Bittling Building  
Wichita, Kansas

NORTH

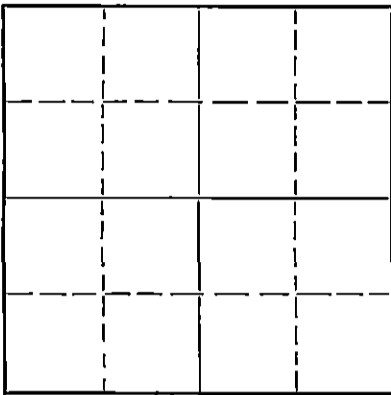

Locate well correctly on above  
Section Plot

Stafford County. Sec. 4 Twp. 22 Rge. (E) 11(W)  
Location as "NE/CNW $\frac{1}{4}$ SW $\frac{1}{4}$ " or footage from lines SE SE NE  
Lease Owner E. H. Adair  
Lease Name Fair Well No. 1  
Office Address 407 W-K-H Building, Wichita, Kansas  
Character of Well (completed as Oil, Gas or Dry Hole) Dry Hole  
Date well completed January 19, 19 51  
Application for plugging filed January 19, 19 51  
Application for plugging approved January 19, 19 51  
Plugging commenced January 19, 19 51  
Plugging completed January 19, 19 51  
Reason for abandonment of well or producing formation Barren

If a producing well is abandoned, date of last production 19  
Was permission obtained from the Conservation Division or its agents before plugging was commenced? Yes

Name of Conservation Agent who supervised plugging of this well C. D. Stough  
Producing formation \_\_\_\_\_ Depth to top \_\_\_\_\_ Bottom \_\_\_\_\_ Total Depth of Well 3540 Feet  
Show depth and thickness of all water, oil and gas formations.

OIL, GAS OR WATER RECORDS

CASING RECORD

Formation	Content	From	To	Size	Put In	Pulled Out
Copy of well log attached						

Describe in detail the manner in which the well was plugged, indicating where the mud fluid was placed and the method or methods used in introducing it into the hole. If cement or other plugs were used, state the character of same and depth placed, from \_\_\_\_\_ feet to \_\_\_\_\_ feet for each plug set.

Placed plug at 246' put 15 sx cemet onplug, filled hole with mud up to 30' from top, placed plug and filled hole with 10 sx cement up to surface.

**RECEIVED**  
STATE CORPORATION COMMISSION  
FEB 6 1951  
CONSERVATION DIVISION  
Wichita, Kansas

2-6-51

(If additional description is necessary, use BACK of this sheet)

Correspondence regarding this well should be addressed to E. H. Adair Oil Company  
Address 407 W-K-H Building  
Wichita 2, Kansas

STATE OF Kansas, COUNTY OF Sedgwick, ss.  
E. H. Adair (employee of owner) or (owner or operator) of the above-described well,  
being first duly sworn on oath, says: That I have knowledge of the facts, statements, and matters herein contained and the log of the above-described well as filed and that the same are true and correct. So help me God.

(Signature) [Signature]  
Wichita, Kansas (Address)

SUBSCRIBED AND SWORN to before me this 29th day of January, 1951

My commission expires September 15, 1953 Notary Public.

**PLUGGING**  
FILE SEC 4 T 22 R 11W  
BOOK PAGE 59 LINE 14

15-185-00748-00-00

Company: E. H. Adair Oil Company

Stafford County Sec. 4-22-11W

Well No. 1

SE SE NE

Comm. 1/8/51 Comp. 1/19/51

Elevation 1746 DF  
1744 Gr

Total Depth: 3540'

246' 8 5/8" s/cag. 160 sx cement

DA

Sand	0-90
Shale	90-600
Shale & Anhydrite	600-1100
Shale	1100-1480
Lime	1480-1665
Lime & Shale	1665-1762
Lime	1762-1829
Lime & Shale	1829-1935
Shale	1935-1990
Shale & Shells	1990-2130
Shale	2130-2320
Shale & Shells	2320-2495
Shale	2495-2683
Lime	2683-2786
Shale & Shells	2786-2875
Lime	2875-3080
Shale	3080-3118
Lime	3118-3418
Conglomerate	3418-3423
Viola Chert	3423-3451
Lime	3451-3458
Shale	3458-3485
Lime Arbuckle	3485-3540

Certified Correct

RECEIVED  
STATE CORPORATION COMMISSION  
FEB 6 1951  
CONSERVATION DIVISION  
Wichita, Kansas

2-6-51

PLUGGING  
FILE SEC 4-22-11W  
BOOK PAGE 57 LINE 14