

R

STATE OF KANSAS  
STATE CORPORATION COMMISSION

Form CP-4

WELL PLUGGING RECORD

Give All Information Completely  
Make Required Affidavit  
Mail or Deliver Report to:  
Conservation Division  
State Corporation Commission  
212 No. Market  
Wichita, Kansas

Stafford County. Sec. 4 Twp. 22S Rge. 11W (E) (W)

Location as "NE/CNW/SW" or footage from lines NW NE NE

Lease Owner Ben C. W. Hyde, Jr.

Lease Name FAIR Well No. 1

Office Address 4000 Somerset Drive, Prairie Village, Kansas

Character of Well (completed as Oil, Gas or Dry Hole) Dry Hole

Date well completed October 27 19 68

Application for plugging filed October 28 19 68

Application for plugging approved October 27 19 68


Plugging commenced October 27 19 68

Plugging completed October 27 19 68

Reason for abandonment of well or producing formation Dry Hole

If a producing well is abandoned, date of last production 19

Was permission obtained from the Conservation Division or its agents before plugging was commenced? yes

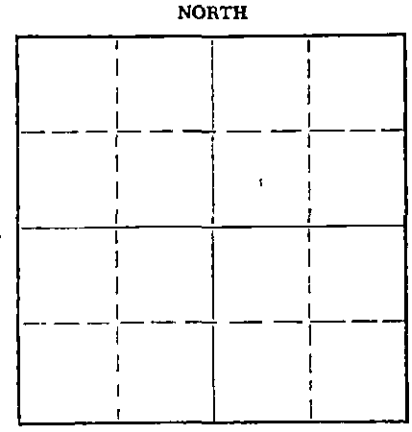

Name of Conservation Agent who supervised plugging of this well Archie V. Elving R.J. Warten

Producing formation Depth to top Bottom Total Depth of Well 3458 Feet

Show depth and thickness of all water, oil and gas formations.

OIL, GAS OR WATER RECORDS

CASING RECORD

Table with 7 columns: FORMATION, CONTENT, FROM, TO, SIZE, PUT IN, PULLED OUT. Row 1: Red Rock, 115, 252, 8 5/8", 249', NONE.

Describe in detail the manner in which the well was plugged, indicating where the mud fluid was placed and the method or methods used in introducing it into the hole. If cement or other plugs were used, state the character of same and depth placed, from feet to feet for each plug set.

50 sacks @ 600', plug 25 sacks @ 240',  
1/2 sack hulls, pulg and 10 sacks cement @ 40'.

Two sacks in rat hole.

Job completed 12 noon October 27, 1968.

RECEIVED  
STATE CORPORATION COMMISSION  
OCT 29 1968  
CONSERVATION DIVISION  
Wichita, Kansas

Name of Plugging Contractor Isern Drilling Company  
Address Box 486, Ellinwood, Kansas 67526

STATE OF KANSAS, COUNTY OF BARTON, ss.  
W. F. Banks (employee of Isern) or (owner) operator of the above-described well, being first duly sworn on oath, says: That I have knowledge of the facts, statements, and matters herein contained and the log of the above-described well as filed and that the same are true and correct. So help me God.

(Signature) W. F. Banks

Box 486, Ellinwood, Kansas 67526 (Address)

SUBSCRIBED AND SWORN TO before me this 28th day of October, 1968

George A. Meyer Notary Public

My commission expires February 10, 1971

W E L L L O GRECEIVED  
STATE CORPORATION COMMISSIONDEC 20 1968  
CONSERVATION DIVISION  
Wichita, KansasBen C. W. Hyde, Jr., FAIR #1  
NW NE NE, Section 4-22S-11W  
Stafford County, KansasELEVATION: 1739' GL      Figures indicate bottom of formation:  
          1741' DF  
          1743' KB.

0	to	40	sand & clay
		115	clay & shale
		451	red bed
		1520	shale & shells
		1985	lime & shale
		2850	shale & shells
		2990	lime & shale
		3092	shale & lime
		3315	lime & shale
		3405	lime & shale with chert
		3417	sand
		3418	shale
		3445	shale & lime
		3460	lime & shale
		3460	Rotary Total Depth

PIPE RECORD:  
8 5/8" set @ 249' with  
250 sacks cement.  
Dry and AbandonedROTARY COMMENCED: 10-19-68  
ROTARY COMPLETED: 10-27-68TOPS


Anhydrite	470
Heebner	2959
Toronto	2976
Douglas	2990
Brown Lime	3092
Lansing	3111
Arbuckle	3451

STATE OF KANSAS )  
COUNTY OF BARTON ) ss

I, W. F. Banks, Drilling Superintendent, of Isern Drilling Company, contractor for the above-described well, being first duly sworn on oath, declare: That I have knowledge of the facts, statements and matter herein contained pertaining to the log of the above-described well, as filed, and that the same are true and correct.

  
 \_\_\_\_\_  
 W. F. Banks

Subscribed and sworn to before me on this 30th day of October, 1968.

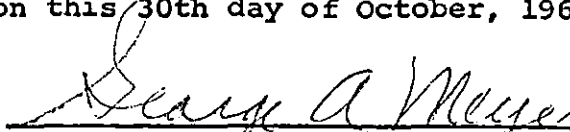  
 \_\_\_\_\_  
 George A. Meyer, Notary Public

My Commission Expires: February 10, 1971.