


Give All Information Completely
Make Required Affidavit
Mail or Deliver Report to:
Conservation Division
State Corporation Commission
211 No. Broadway
Wichita, Kansas

WELL PLUGGING RECORD

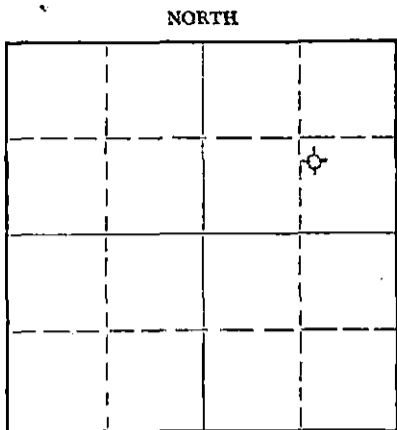

Locate well correctly on above Section Plat

Stafford County. Sec. 25 Twp. 22 Rge. 12 (E) W (W)
Location as "NE/CNW/SW" or footage from lines NW SE NE
Lease Owner Osage Oil & Gas Co., Inc.
Lease Name Heyen Well No. 1
Office Address 709 Petroleum Building
Character of Well (completed as Oil, Gas or Dry Hole) Dry Hole
Date well completed September 15 1956
Application for plugging filed September 15 1956
Application for plugging approved September 15 1956
Plugging commenced September 16 1956
Plugging completed September 16 1956
Reason for abandonment of well or producing formation Too low structurally

If a producing well is abandoned, date of last production 19
Was permission obtained from the Conservation Division or its agents before plugging was commenced? Yes

Name of Conservation Agent who supervised plugging of this well Eldon Petty
Producing formation _____ Depth to top _____ Bottom _____ Total Depth of Well 3695 Feet
Show depth and thickness of all water, oil and gas formations.

OIL, GAS OR WATER RECORDS

CASING RECORD

FORMATION	CONTENT	FROM	TO	SIZE	PUT IN	PULLED OUT
				8-5/8"	244'	none

Describe in detail the manner in which the well was plugged, indicating where the mud fluid was placed and the method or methods used in introducing it into the hole. If cement or other plugs were used, state the character of same and depth placed, from _____ feet to _____ feet for each plug set.

Filled hole with heavy mud to 240'. Set plug. Put in 1/2 sack of Hulls and 15 sacks of Cement. Filled with heavy mud up to 40'. Set plug. Filled to top with 1/2 sack Hulls and 10 sacks of cement.

(If additional description is necessary, use BACK of this sheet)

Name of Plugging Contractor C-G Drilling Co.
Address 107 Rule Building, Wichita, Kansas

STATE OF KANSAS, COUNTY OF SEDGWICK, ss.
Jay H. Galloway (employee of owner) or (owner or operator) of the above-described well, being first duly sworn on oath, says: That I have knowledge of the facts, statements, and matters herein contained and the log of the above-described well as filed and that the same are true and correct. So help me God.

(Signature) Jay H. Galloway 9-21-56
Jay H. Galloway 107 Rule Bldg.
(Address)

SUBSCRIBED AND SWORN TO before me this 20th day of September 1956

Vicky Jacobs
Vicky Jacobs Notary Public.

My commission expires May 20, 1959

PLUGGING
FILE SEC 25 T. 22 R. 12W
BOOK PAGE 100 LINE 5

CONSERVATION DIVISION
WICHITA, KANSAS

CONTRACTOR'S WELL LOG

OPERATOR OSAGE OIL & GAS CO., INC. WELL NAME HEYEN #1
 LOCATION NW SE NE SECTION 25-22-12W RIG NO. 2
 COUNTY STAFFORD STATE KANSAS
 COMMENCEMENT DATE SEPTEMBER 4, 1956 COMPLETION DATE SEPTEMBER 15, 1956

LOG OF WELL

Elevation 1841' rotary bushing..
 All measurements taken from the top of rotary bushing.

FROM	TO	FORMATION	DEVIATION FROM VERTICAL	REMARKS
0	180	Sand-Shale		
180	244	Sand-Shale		
244	340	Shale		
340	574	Red Shale-Sand		
574-	612	Anhydrite		
612	1405	Shale-Shells		
1405	1500	Shale-Shells		
1500	1595	Sand-Shale		
1595	1700	Lime-Shale		
1700	1825	Lime-Shale		
1825	1940	Lime-Shale		
1940	2080	Lime-Shale		
2080	2200	Lime-Shale		
2200	2380	Shale-Lime		
2380	2510	Shale-Lime	0° - 2500	
2510	2600	Shale-Lime		
2600	2750	Shale-Lime	0° - 2750	
2750	2905	Shale-Lime		
2905	3065	Lime-Shale	0° - 3000	
3065	3118	Lime-Shale		
3118	3205	Lime-Shale		
3205	3325	Lime-Shale	0° - 3250	
3325	3404	Lime-Shale		
3404	3540	Lime-Shale	0° - 3500	DST 3443-61'
3540	3582	Lime-Shale		
3582	3605	Lime		DST 3561-80
3605	3666	Lime		
3666	3695	Arbuckle		DST 3661-66

CASING LEFT IN HOLE AFTER COMPLETION

Set 244' (12 jts.) of 8-5/8" OD Surface Casing.

STATE OF KANSAS }
 COUNTY OF SEDGWICK } SS.

RECORDED
 & INDEXED
 OCT 21 1956
 DISTRICT RECORDS DIVISION
 WICHITA, KANSAS

The undersigned hereby certifies that to the best of his knowledge and belief, the above facts are true and correct.

C-G DRILLING CO.

By Jay H. Galloway
 Jay H. Galloway

Subscribed and sworn to before me this 20th day of September, 1956.

Vicky Jacobs
 Vicky Jacobs, Notary Public

My commission expires:
 May 20, 1959

PLUGGING
 FILE SEC 25 T 22 R12W
 BOOK PAGE 100 LINE 5