

15-185-20957-0000


STATE OF KANSAS  
STATE CORPORATION COMMISSION

WELL PLUGGING RECORD

Give All Information Completely.  
Make Required Affidavit  
Mail or Deliver Report to  
Conservation Division  
State Corporation Comm.  
245 North Water  
Wichita, KS 67202

Stafford County, Sec. 25 Twp. 22 Rge. 12 E/Wx  
Location as "NE/CNW $\frac{1}{4}$ SW $\frac{1}{4}$ " or footage from lines

SE SW SE  
Lease Owner White & Ellis Drilling, Inc  
Lease Name Heyen Well No. 167202  
Office Address 401 E. Douglas Suite 500, Wichita, Kansas  
Character of Well (Completed as Oil, Gas or Dry Hole)

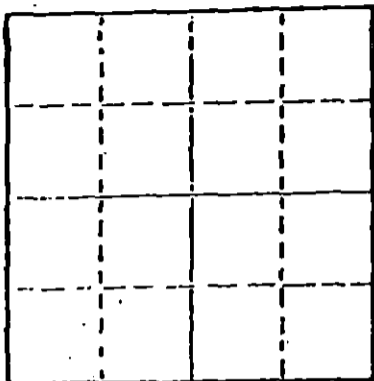

Locate well correctly on above  
Section Plat

dry hole  
Date Well completed June 19 1980  
Application for plugging filed June 19 1980  
Application for plugging approved June 19 1980  
Plugging commenced June 19 1980  
Plugging completed June 19 1980  
Reason for abandonment of well or producing formation

dry hole  
If a producing well is abandoned, date of last production 19

Was permission obtained from the Conservation Division or its agents before plugging was commenced? yes

Name of Conservation Agent who supervised plugging of this well  
Producing formation Depth to top Bottom Total Depth of Well 3665  
Show depth and thickness of all water, oil and gas formations.

OIL, GAS OR WATER RECORDS

CASING RECORD

FORMATION	CONTENT	FROM	TO	SIZE	PUT IN	PULLED OUT
				8 5/8	254	

Describe in detail the manner in which the well was plugged, indicating where the mud flu was placed and the method or methods used in introducing it into the hold. If cement or oth plugs were used, state the character of same and depth placed, from feet to feet for each plug set.

1st plug 540 w/40 sx.  
2nd plug 240 w/40 sx.  
3rd plug 40 w/10 sx/

10 sx in rathole

(If additional description is necessary, use BACK of this sheet)

Name of Plugging Contractor Woodman & Iannitti Drilling Co.


STATE OF KANSAS COUNTY OF SEDGWICK, ss.  
K. T. Woodman (employee of owner) or (owner or operat

of the above-described well, being first duly sworn on oath, says: That I have knowledge of the facts, statements, and matters herein contained and the log of the above-described well as filed and that the same are true and correct. So help me God.

(Signature) K. T. Woodman 6-30-80  
1008 Douglas Bldg. Wichita, Kansas 6720  
(Address)

SUBSCRIBED AND SWORN TO before me this 27th day of CONSERVATION DIVISION June, 19 80  
Wichita, Kansas

My commission expires Feb. 11, 1984  
Justina Chamberlain Notary Public.

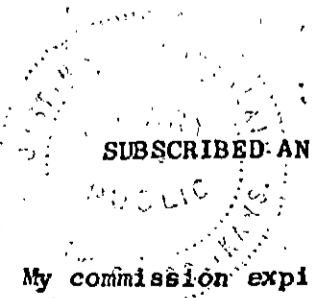

K. T. WOODMAN  
 RES. PHONE 733-0418  
 OFF. PHONE 265-7650  
 WICHITA, KANSAS

D. J. IANNITTI  
 PHONE 792-2921  
 GREAT BEND, KANSAS

## WOODMAN & IANNITTI DRILLING COMPANY

*Rotary Drilling Contractors*

1008 DOUGLAS BUILDING  
 104 S. BROADWAY  
 WICHITA, KANSAS 67202

June 27, 1980

Company;	White & Ellis Drilling, Inc.
Farm:	#1 Heyen
Location;	SE SW SE
Section;	25-22-12W
County;	Stafford
Contractor;	Woodman & Iannitti Drilling Co.
Comm;	June 12, 1980
Compl;	June 19, 1980
Total Depth;	3665'
Casing;	8 5/8 @ 254 w/225 sx.
Production;	D & A

Figures Indicate Bottom Of Formations;

25	Clay
70	Sand
135	Sand
254	Redbed
555	Redbed
585	Anhy
1392	Shale
1565	Shale & lime
2200	Shale
3165	Shale & lime
3320	Lime & shale
3540	Lime
3555	Lime & shale
3645	Lime
3665	Lime

I certify the above to be a true and correct copy of the drillers log to the best of my knowledge and belief.

Woodman & Iannitti Drilling Co.

*K. T. Woodman*  
 K. T. Woodman

RECEIVED  
 JUN 30 1980  
 STATE COMMISSION