


STATE OF KANSAS
STATE CORPORATION COMMISSION

WELL PLUGGING RECORD

Give All Information Completely
Make Required Affidavit
Mail or Deliver Report to:
Conservation Division
State Corporation Commission
211 No. Broadway
Wichita, Kansas

Stafford County, Sec. 33 Twp. 22 Rge. 13 ~~W~~ (W)
Location as "NE/CNW/SW" or footage from lines SW SW NW
Lease Owner Woodman & Tannitti Drilling Co.
Lease Name Durham Well No. 1-D
Office Address 706 Union Nat'l. Bldg., Wichita
Character of Well (completed as Oil, Gas or Dry Hole) dry hole
Date well completed 7-28 1963
Application for plugging filed 7-28 1963
Application for plugging approved 7-28 1963
Plugging commenced 7-28 1963
Plugging completed 7-28 1963
Reason for abandonment of well or producing formation dry hole

NORTH

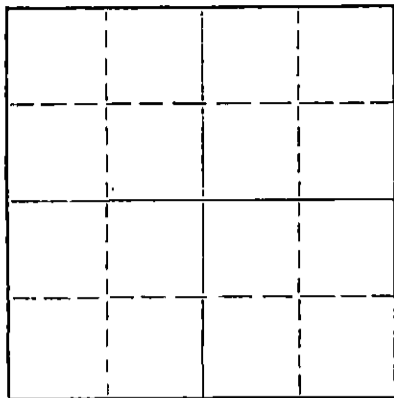

Locate well correctly on above
Section Plat

If a producing well is abandoned, date of last production _____ 19____
Was permission obtained from the Conservation Division or its agents before plugging was commenced? yes

Name of Conservation Agent who supervised plugging of this well Archie V. Elving
Producing formation _____ Depth to top _____ Bottom _____ Total Depth of Well 3905 Feet
Show depth and thickness of all water, oil and gas formations.

OIL, GAS OR WATER RECORDS

CASING RECORD

FORMATION	CONTENT	FROM	TO	SIZE	PUT IN	PULLED OUT
				8 5/8	328	

Describe in detail the manner in which the well was plugged, indicating where the mud fluid was placed and the method or methods used in introducing it into the hole. If cement or other plugs were used, state the character of same and depth placed, from _____ feet to _____ feet for each plug set.

Bottom Plug @ 300' w/20 sax cement
Top Plug @ 40" w/10 sax cement

RECEIVED
STATE CORPORATION COMMISSION

JUL 30 1963

CONSERVATION DIVISION
Wichita, Kansas

(If additional description is necessary, use BACK of this sheet)

Name of Plugging Contractor Woodman & Tannitti Drilling Co.
Address 706 Union Nat'l. Bldg., Wichita

STATE OF Kansas, COUNTY OF Sedgwick, ss.
K. T. Woodman (employee of owner) or (owner or operator) of the above-described well, being first duly sworn on oath, says: That I have knowledge of the facts, statements, and matters herein contained and the log of the above-described well as filed and that the same are true and correct. So help me God.

(Signature) K. T. Woodman
706 Union Nat'l. Bldg., Wichita
(Address)

SUBSCRIBED AND SWORN TO before me this 29th day of July, 1963

My commission expires Oct. 10, 1963 Francis H. Salomon Notary Public.



KANSAS GEOLOGICAL SOCIETY
KANSAS WELL LOG BUREAU - KANSAS WELL SAMPLE BUREAU
KANSAS GEOLOGICAL SOCIETY BUILDING
508 EAST MURDOCK - WICHITA, KANSAS

COMPANY Woodman & Iannitti Drilling Co.

SEC. 33 T. 22 R. 13W
LOC. SW SW NW

FARM Durham

NO. 1 - D

TOTAL DEPTH 3905

COUNTY Stafford

COMM. 7-18-63


COMP. 7-28-63

KANSAS

SHOT OR TREATED

CONTRACTOR Woodman & Iannitti Drilling Co.

ISSUED

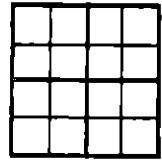

CASING

20	10
15	8 5/8 @ 328 w/200 sx cement
12	6
13	5

ELEVATION 1909 RB

PRODUCTION

FIGURES INDICATE BOTTOM OF FORMATIONS

0 -	20	Clay
	280	Sand
	785	Red Bed
	821	Anhydrite
	1200	Shale
	1635	Shale & Shells
	1820	Shale & Lime
	2470	Lime
	2650	Lime & Shale
	2860	Lime
	3245	Lime & Shale
	3335	Lime
	3440	Lime & Shale
	3755	Lime
	3905	Lime & Chert

I certify the above to be a true and correct copy of the Driller's Log to the best of my knowledge and belief.

WOODMAN & IANNITTI DRILLING CO.

By: K. T. Woodman
K. T. Woodman

RECEIVED
STATE CORPORATION COMMISSION

JUL 30 1963

CONSERVATION DIVISION
Wichita, Kansas