


Give All Information Completely
Make Required Affidavit
Mail or Deliver Report to:
Conservation Division
State Corporation Commission
800 Bittling Building
Wichita, Kansas

WELL PLUGGING RECORD

Stafford County, Sec. 36 Twp. 22 Rge. (E) 13 (W)

Location as "NE/CNWxSWx" or footage from lines _____
Lease Owner Arnold L. Kimmes
Lease Name Durham Well No. 1
Office Address #1 Equitable Building, Denver, Colorado
Character of Well (completed as Oil, Gas or Dry Hole) Dry Hole
Date well completed August 17 1955
Application for plugging filed August 1955
Application for plugging approved August 1955
Plugging commenced August 17 1955
Plugging completed August 17 1955
Reason for abandonment of well or producing formation Dry Hole

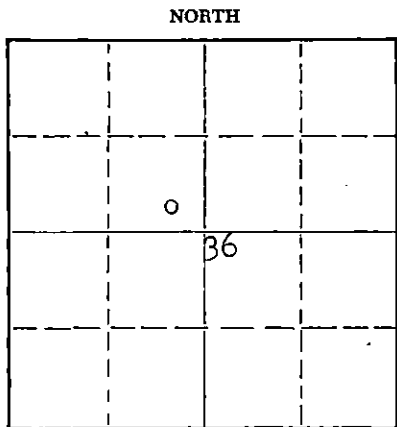

Locate well correctly on above Section Plat

If a producing well is abandoned, date of last production _____ 19____
Was permission obtained from the Conservation Division or its agents before plugging was commenced? Yes

Name of Conservation Agent who supervised plugging of this well M. A. Rives, Box 8, Pratt, Kansas
Producing formation _____ Depth to top _____ Bottom _____ Total Depth of Well 3847 Feet
Show depth and thickness of all water, oil and gas formations.

OIL, GAS OR WATER RECORDS

CASING RECORD

FORMATION	CONTENT	FROM	TO	SIZE	PUT IN	PULLED OUT
				8-5/8	251'	

Describe in detail the manner in which the well was plugged, indicating where the mud fluid was placed and the method or methods used in introducing it into the hole. If cement or other plugs were used, state the character of same and depth placed, from _____ feet to _____ feet for each plug set.

Filled hole with mud to 245'. Set plug with 1/2 sack hulls and 20 sacks cement.
Filled hole with mud to 35'. Set plug with 1/2 sack hulls, and 10. sacks cement.


(If additional description is necessary, use BACK of this sheet)
Name of Plugging Contractor Rocket Drilling Company, Inc.
Address 352 North Broadway, Wichita 2, Kansas

STATE OF KANSAS, COUNTY OF SEDGWICK, ss.
L.H. Myrick, agent for Rocket Drilg. Co., Inc. (~~employee of owner~~ or ~~owner~~ or ~~operator~~) of the above-described well, being first duly sworn on oath, says: That I have knowledge of the facts, statements, and matters herein contained and the log of the above-described well as filed and that the same are true and correct. So help me God.
(Signature) L. H. Myrick (Address) _____

SUBSCRIBED AND SWORN TO before me this 14 day of December, 19 55
My commission expires 10-28-1959
Jeanne Helmer Spence Notary Public.

PLUGGING
FILE SEC 36 T 22 R 13W
BOOK PAGE 144 LINE 20

12-15-55
STATE CORPORATION COMMISSION
Wichita, Kansas

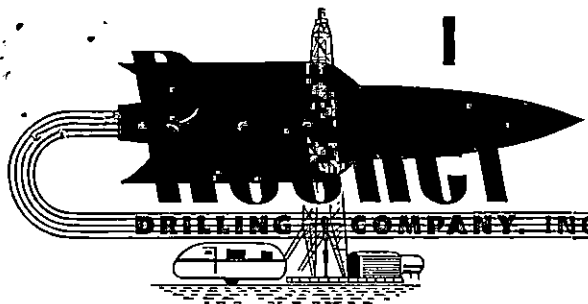

15-185-11600-0000

DRILLING COMPANY, INC. (Chest 3-1279) 352 N. BROADWAY WICHITA, KANSAS

Arnold L. Kimmes
 #1 Durham
 SE SE NW Section 36-22-13W
 Stafford County, Kansas

Mr. Arnold L. Kimmes
 Columbia Securities Company
 Number 1 Equitable Building
 Denver, Colorado

Elevation: 1886 R.B.
 Spudded: August 5, 1955
 Rotary Completed: August 17, 1955
 Results: Dry and Abandoned
 Contractor: Rocket Drilling Company, Inc.

CASING RECORD

251' of 8-5/8" O.D. 24# seamless casing cemented with 175 sacks cement.

DRILLERS LOG

Sand & Clay	0 to 222	Lime	2180
Shale	725	Sand	2190
Anhydrite	750	Lime	2315
Shale & Shells	1225	Shale & Lime	3142
Shale, Shells & Salt	1550	Lime	3194
Sand	1580	Lime & Shale	3403
Lime & Shale	1645	Lime	3625
Lime	1650	Shale & Chert	3710
Sand	1660	Chert	3735
Lime	1925	Conglomerate	3743
Sand	1935	Chert & Shale	3762
Lime	1985	Shale	3808
Sand	2005	Arbuckle	3847 TD

STATE OF KANSAS)
) SS:
 COUNTY OF SEDGWICK)

I hereby certify that to the best of my knowledge and belief, the foregoing log is true and correct.

ROCKET DRILLING COMPANY, INC.

L. H. Myrick
 L. H. Myrick

Subscribed and sworn to before me, a Notary Public, in and for the County and State aforesaid, this 24th day of August, 1955.

Patricia McBlume
 Notary Public

My commission expires: March 5, 1958.

